12341

PLACE

12341

Sub Doc Type

BL

Number LG Docs

0015

Box Number

Street #

1371

Street Dir

Doc Type

PL

Street Name

KOOSER

Street Type

RD

Tract Number

Document Date

11/30/78

	Prepped By	Scanned By	Indexed By	Verified By
Initials	RT			
Date	06/06			

SYM	ECO NO.	REVISIONS DESCRIPTION	DATE	APPROVED
△		ZONING DEPT REVISIONS	3-2-79	

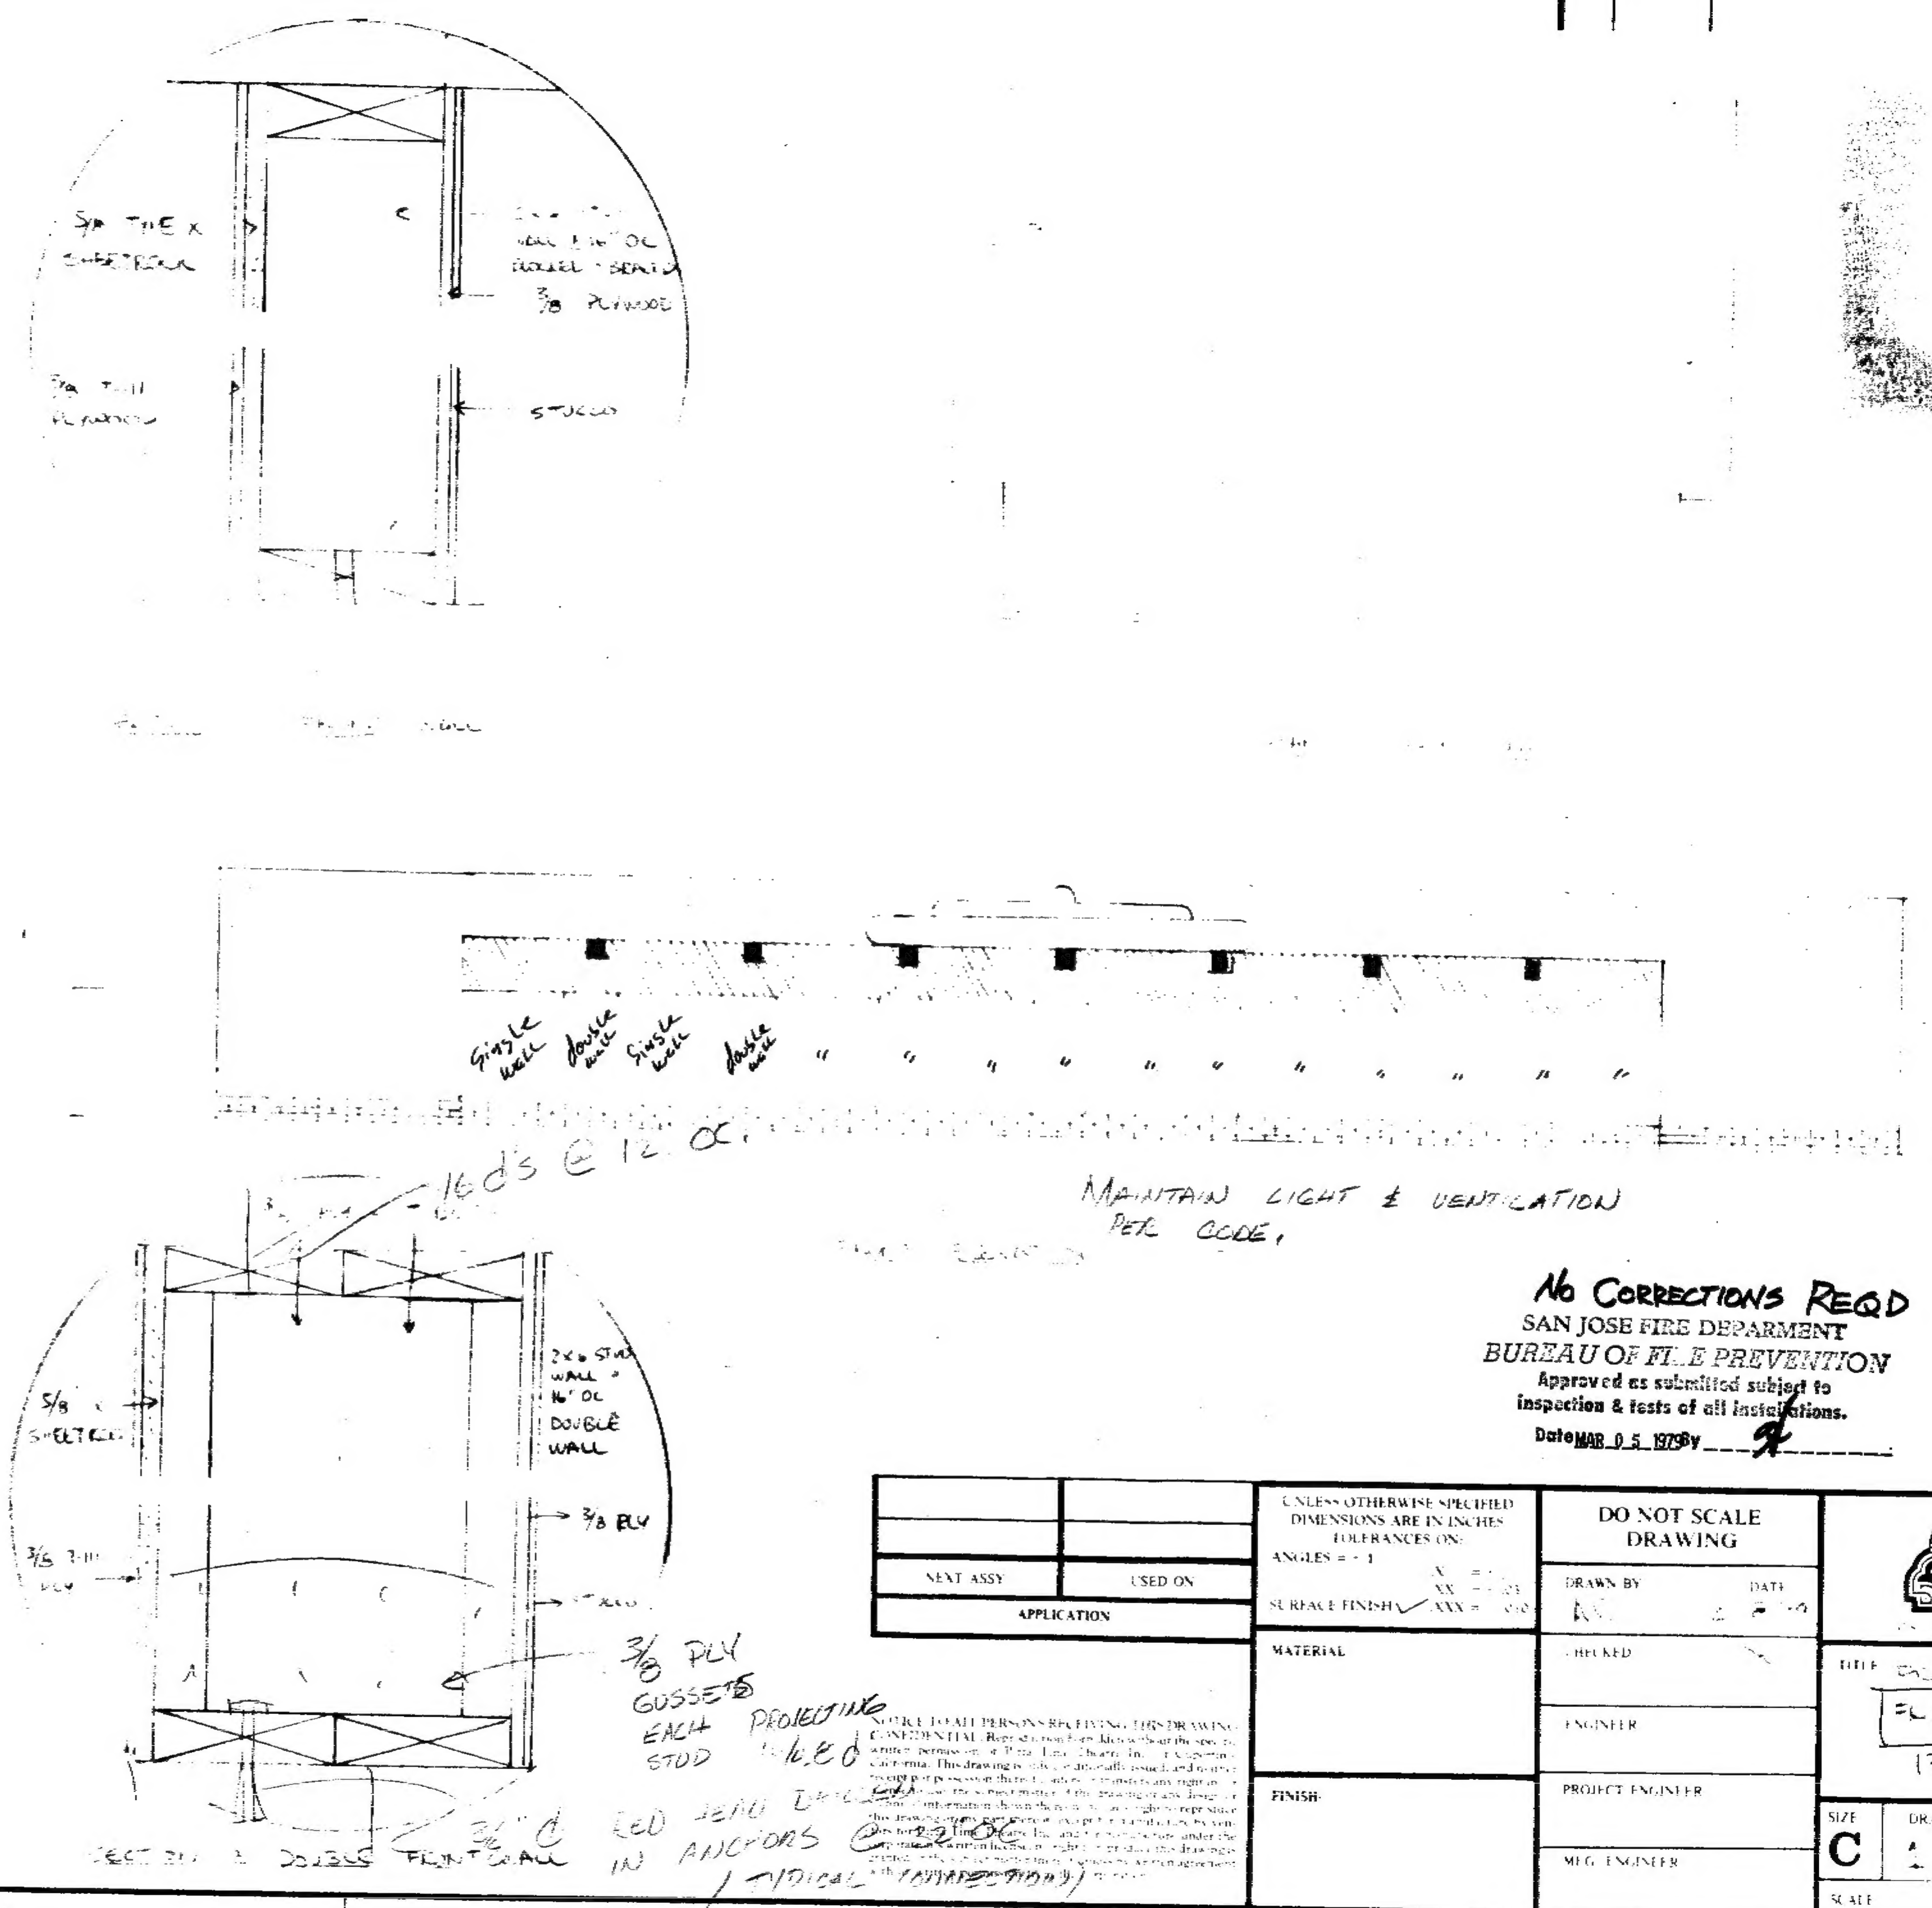

5/8 TYPE X SHEETROCK
5/8 T-111 PLYWOOD
3/8 PLYWOOD
STUCCO
Single wall
double wall
Single wall
double wall
16d's @ 12 OC.
5/8 SHEETROCK
2x6 STUD WALL @ 16" OC DOUBLE WALL
3/8 PLY
3/8 PLY GUSSETS EACH STUD
PROJECTING 16d
SECTION DOUBLE FRONT WALL
3/4" ⌀ LEAD HEAD DROP IN ANCHORS @ 32" OC (TYPICAL CONNECTION)

MAINTAIN LIGHT & VENTILATION PER CODE,

SAN JOSE
BLDG. PLANNING
APPROVED
DENIED
SUBJECT TO CONDITIONS
B. Beaver 3/5/79

Paint to match rest of center.

12841

MAR 02 1979
PLANNING DEPARTMENT

No CORRECTIONS REQD

SAN JOSE FIRE DEPARMENT
BUREAU OF FILE PREVENTION
Approved as submitted subject to inspection & tests of all installations.
Date MAR 0 5 1979 By

OUTSTANDING ECNs	

C-1
A-3
8,733
94
yes

NEXT ASSY	USED ON
APPLICATION	

UNLESS OTHERWISE SPECIFIED
DIMENSIONS ARE IN INCHES
TOLERANCES ON:
ANGLES = ± 1
SURFACE FINISH ✓

DO NOT SCALE DRAWING

DRAWN BY
DATE
CHECKED
ENGINEER
PROJECT ENGINEER
MFG. ENGINEER

MATERIAL

FINISH

Pizza Time Theatre Inc.
10060 Bubb Road
Cupertino, CA 95014

TITLE PIZZA TIME THEATRE CENTER
1371 KOOSER RD.

SIZE C
DRAWING NO.
SCALE
SHEET

TO FPB
13672

w/12341

reg'd for "games". Mr. [illegible]
does not constitute [illegible]
entertainment which [illegible]
permitted in C-1 [illegible]
Per F.A.B. 7/31/78 [illegible]

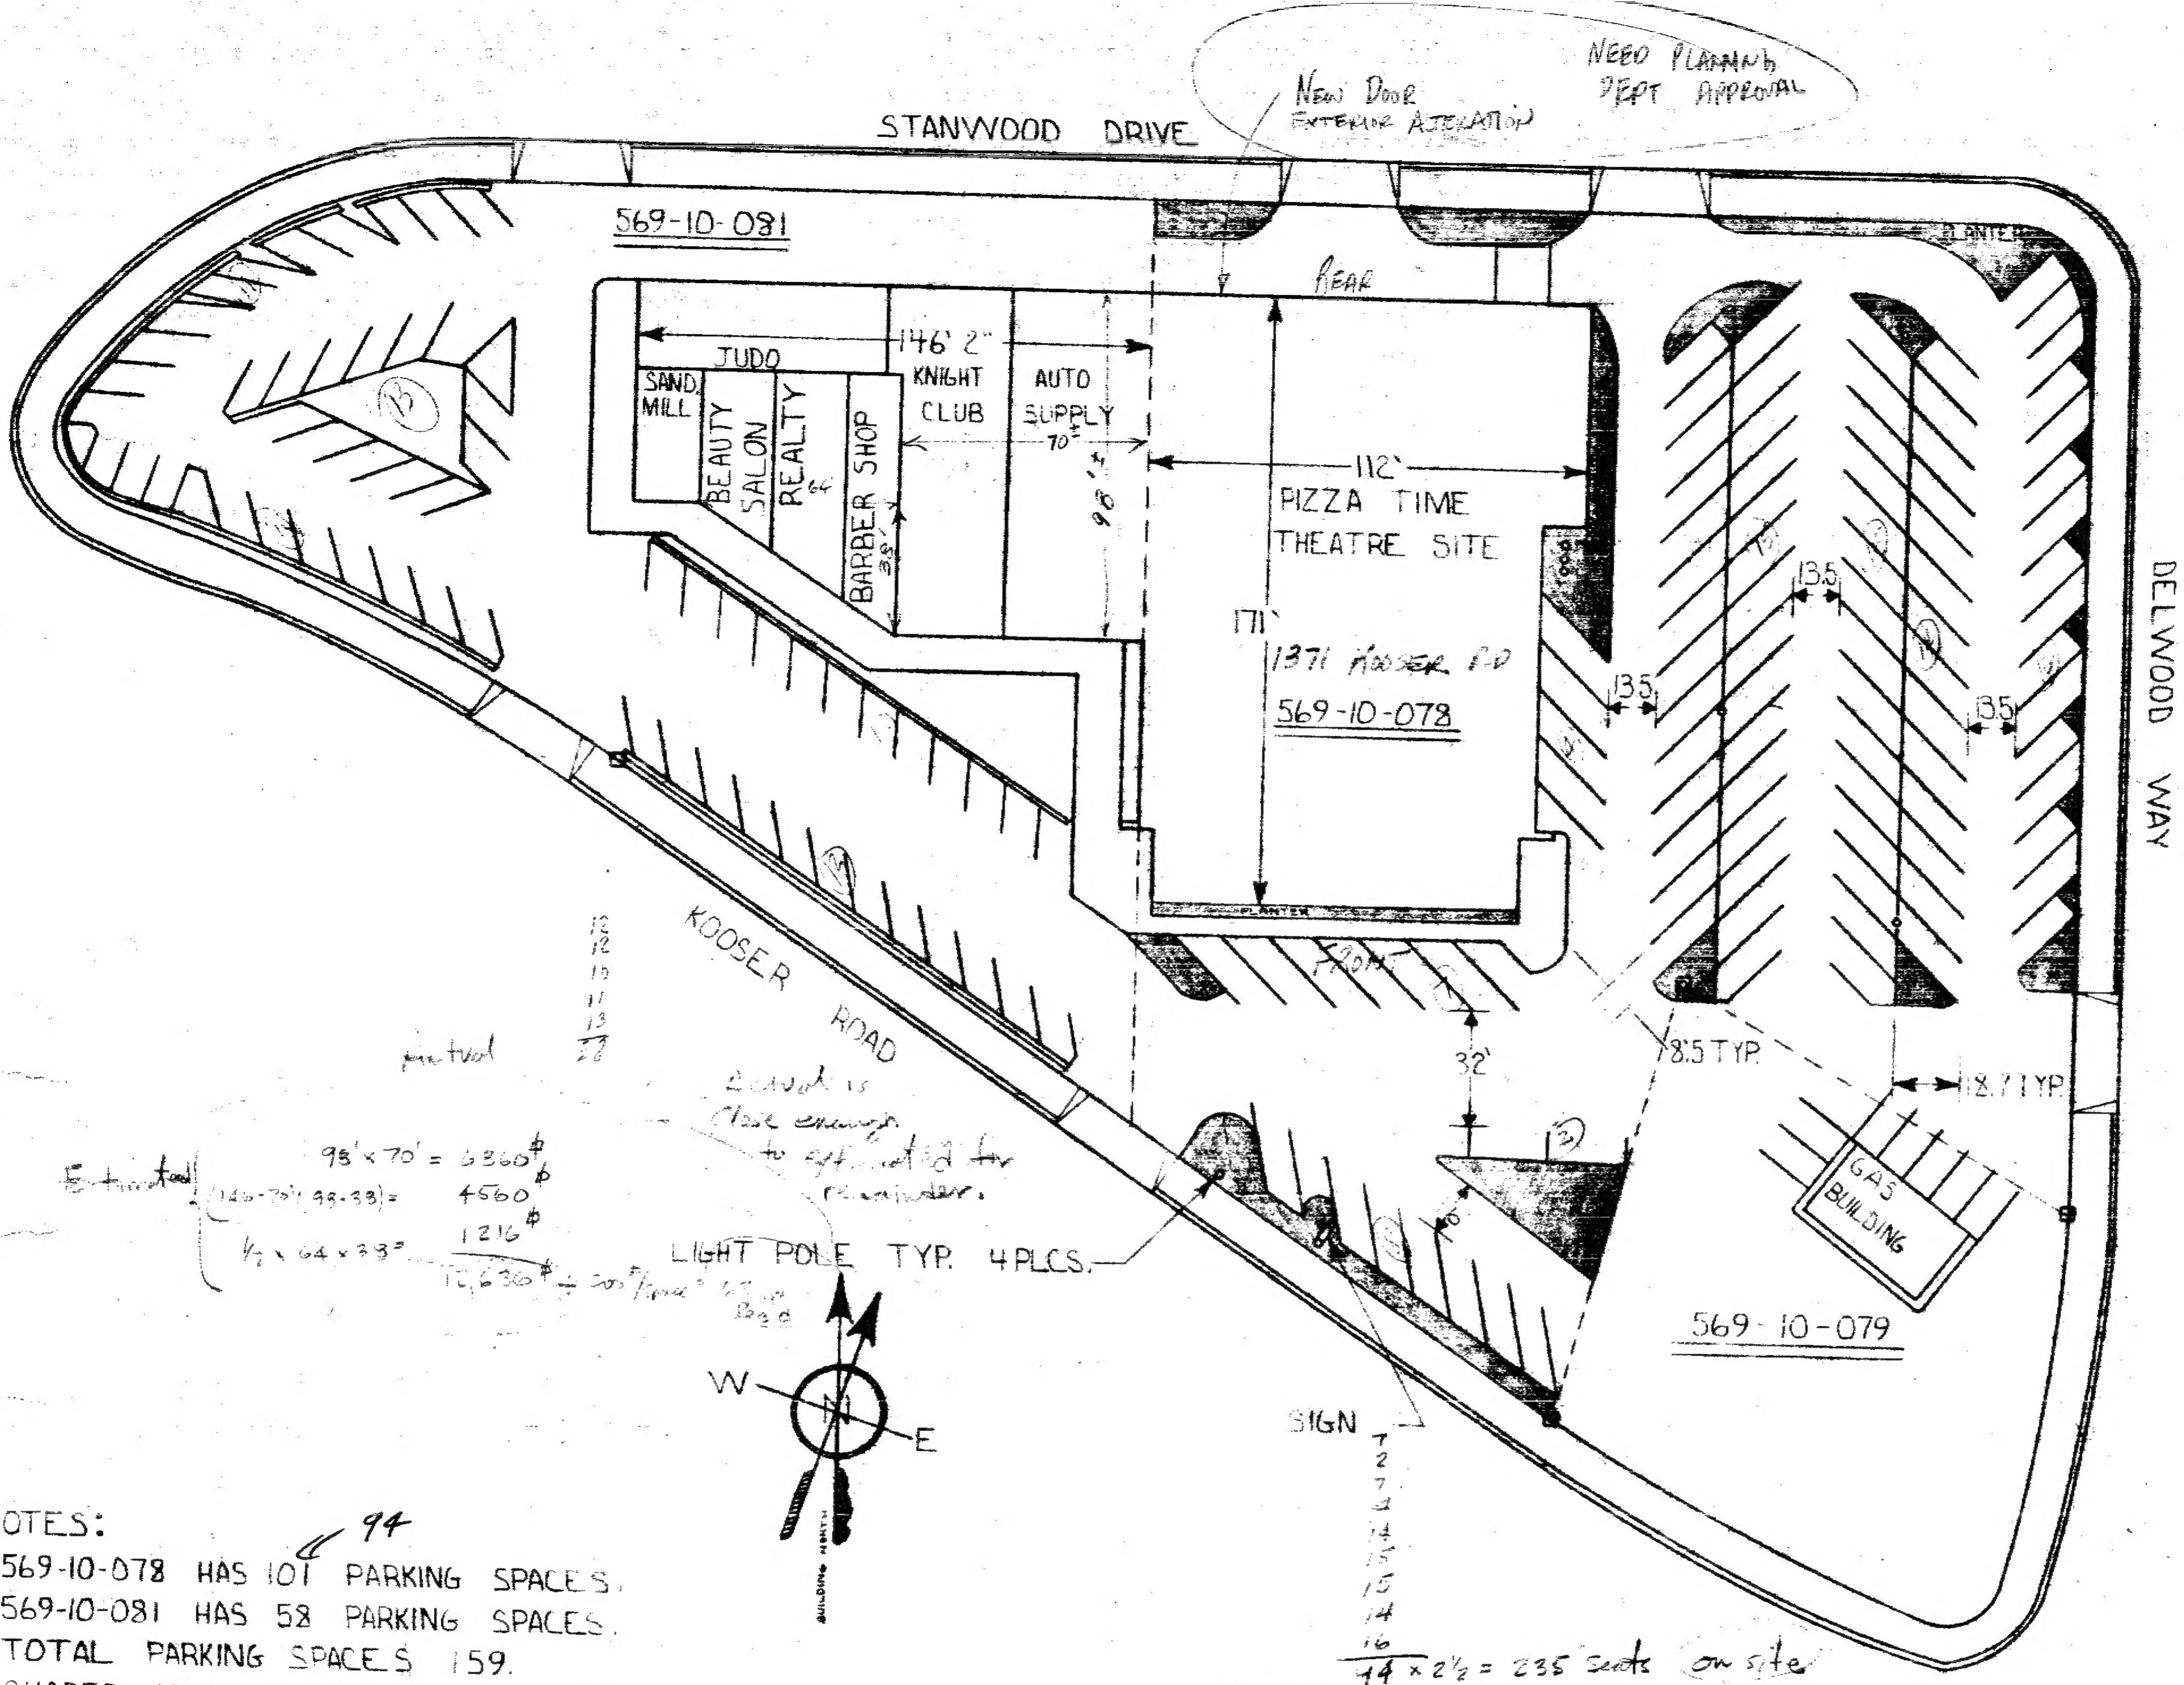

NOTES:
1. 569-10-078 HAS ~~101~~ 94 PARKING SPACES.
2. 569-10-081 HAS 58 PARKING SPACES.
3. TOTAL PARKING SPACES 159.
4. SHADED AREAS REPRESENT PLANTERS.

actual

12
12
15
11
13
22

Estimated
95' × 70' = 6360#
(146-70') 98-38) = 4560#
1/2 × 64 × 38 = 1216#
12,636# ÷ 50#/space = 253 [illegible] Req'd

[illegible] is close enough to estimated for remainder.

7
2
7
3
14
15
15
14
16
94 × 2½ = 235 seats on site
OFF SITE → 7 × 2½ = 17 seats Gas Station
252

NEED PLANNING COMMISSION APPROVAL FOR OFF SITE PARKING

104 × 2.5 = 260

P/C 147.23 $100,000

PERMIT 287.00
SMIPA 7.00
BES@1½ 1500.00
$1794.00

NO ERMP
SUBMITTED 7/17

Made additional P/C 12857X for @ $5000.00 ($20.00) for Change △2

1 STORY METAL
TYPE II-N
B-3 Occupancy
C-1 Zone
Fire Zone 2
13,733#±

#12341 ✓

12341

FORMERLY [illegible]

OUTSTANDING ECNs	
# PECK'S WAREHOUSE	[illegible]

NEXT ASSY	USED ON
APPLICATION	

NOTICE TO ALL PERSONS RECEIVING THIS DRAWING
CONFIDENTIAL: Reproduction Forbidden without the specific written permission of Pizza Time Theatre Inc., Mountain View, California. This drawing is only conditionally issued, and neither receipt nor possession thereof confers or transfers any right in, or license to use, the subject matter of the drawing or any design or technical information shown thereon, nor any right to reproduce this drawing or any part thereof, except for manufacture by vendors for Pizza Time Theatre Inc. and for manufacture under the corporation's written license, no right to reproduce this drawing is granted or the subject matter thereof unless by written agreement with or written permission from the corporation.

UNLESS OTHERWISE SPECIFIED DIMENSIONS ARE IN INCHES
TOLERANCES ON:
ANGLES = ±1°
.x = ± .1
.xx = ± .03
.xxx = ± .005
SURFACE FINISH ✓

MATERIAL:

FINISH:

DO NOT SCALE DRAWING
DRAWN BY Bradley Root DATE 7-7-78
CHECKED
ENGINEER
PROJECT ENGINEER
MFG. ENGINEER

Pizza Time Theatre Inc.
455 N. Bernardo Avenue
Suite A
Mountain View, CA 94043

© 1978 Pizza Time Theatre Inc

TITLE 1371 KOOSER RD
PARKING LOT
KOOSER SITE

2

SIZE D
DRAWING NO BLDG DEPT COPY
REV
SCALE 1/32" = 1'
SHEET 1 OF

15340

12341

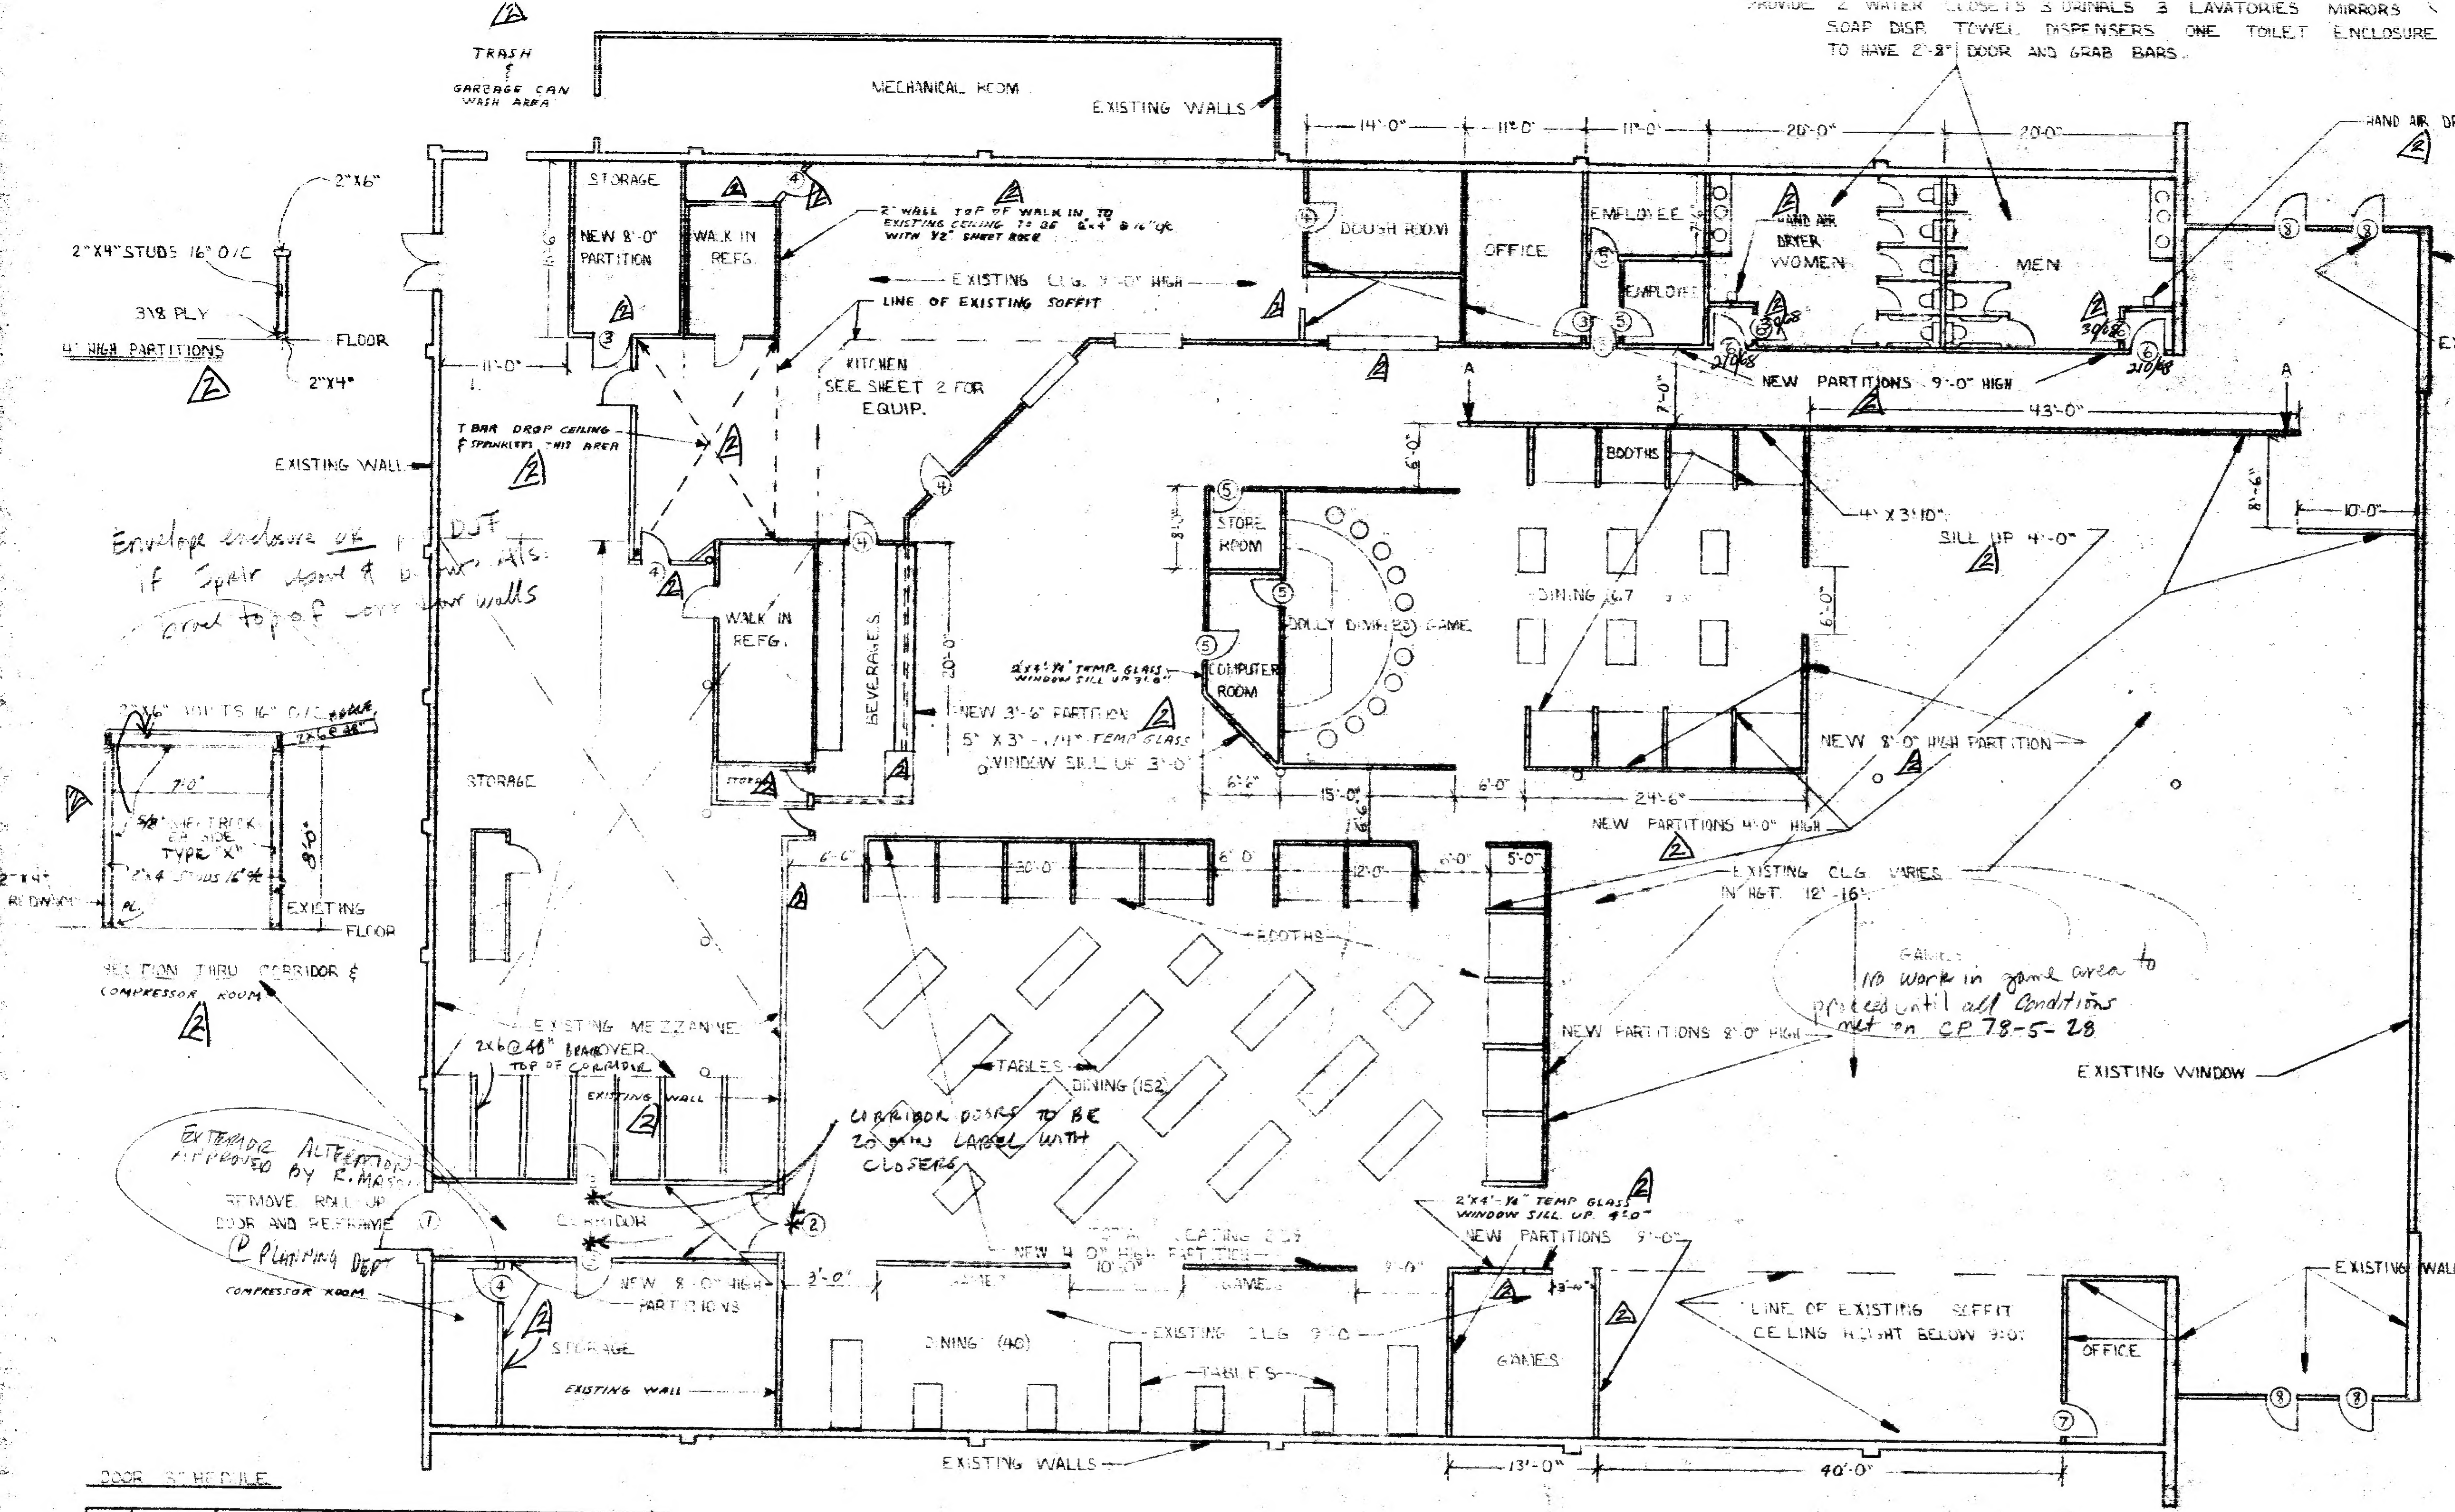
PROVIDE 2 WATER CLOSETS 3 URINALS 3 LAVATORIES MIRRORS
SOAP DISP. TOWEL DISPENSERS ONE TOILET ENCLOSURE
TO HAVE 2'-8" DOOR AND GRAB BARS.
TRASH & GARBAGE CAN WASH AREA
MECHANICAL ROOM
EXISTING WALLS
HAND AIR DRYER
EXISTING WALLS AND DOORS
14'-0"
11'-0"
11'-0"
20'-0"
20'-0"
STORAGE
NEW 8'-0" PARTITION
WALK IN REFG.
2' WALL TOP OF WALK IN TO EXISTING CEILING TO BE 2x4 @ 16" o/c WITH 1/2 SHEET ROCK
EXISTING CLG. 9'-0" HIGH
LINE OF EXISTING SOFFIT
DOUGH ROOM
OFFICE
EMPLOYEE
EMPLOYEE
HAND AIR DRYER
WOMEN
MEN
2'-6"
2"X4" STUDS 16" O/C
3/8 PLY
FLOOR
2"X4"
4' HIGH PARTITIONS
11'-0"
KITCHEN SEE SHEET 2 FOR EQUIP.
T BAR DROP CEILING & SPRINKLERS THIS AREA
EXISTING WALL
NEW PARTITIONS 9'-0" HIGH
43'-0"
7'-0"
6'-0"
BOOTHS
4'X3'10"
SILL UP 4'-0"
8'-6"
10'-0"
STORE ROOM
DOLLY DINING (28) GAME
COMPUTER ROOM
DINING (67)
2'x4'x1/4" TEMP GLASS WINDOW SILL UP 3'-0"
NEW 3'-6" PARTITION
5' X 3' - 1/4" TEMP GLASS WINDOW SILL UP 3'-0"
WALK IN REFG.
BEVERAGES
20'-0"
STORAGE
NEW 8'-0" HIGH PARTITION
6'-6"
15'-0"
6'-0"
24'-6"
NEW PARTITIONS 4'-0" HIGH
EXISTING CLG. VARIES IN HGT. 12'-16'
Envelope enclosure or DJT
If Spair used & [illegible] Als.
Cond top of corr [illegible] walls
2x6 joists 16" o/c
5/8" sheetrock ea. side type "X"
2x4 studs 16"
8'-0"
EXISTING FLOOR
SECTION THRU CORRIDOR & COMPRESSOR ROOM
BOOTHS
GAMES
No work in game area to proceed until all conditions met on CP 78-5-28
NEW PARTITIONS 8'-0" HIGH
EXISTING WINDOW
EXISTING MEZZANINE
2x6@48" BRACE OVER TOP OF CORRIDOR
EXISTING WALL
TABLES
DINING (152)
CORRIDOR DOORS TO BE 20 MIN LABEL WITH CLOSERS
Exterior Alteration Approved by R. Mason
REMOVE ROLL UP DOOR AND REFRAME
@ Planning Dept
CORRIDOR
COMPRESSOR ROOM
NEW 8'-0" HIGH PARTITIONS
STORAGE
EXISTING WALL
TOTAL SEATING 259
NEW 4'-0" HIGH PARTITION
10'-0"
GAMES
DINING (40)
TABLES
EXISTING CLG. 9'-0"
3'-0"
9'-0"
2'x4'x1/4" TEMP GLASS WINDOW SILL UP 4'-0"
NEW PARTITIONS 9'-0"
LINE OF EXISTING SOFFIT CEILING HEIGHT BELOW 9'-0"
GAMES
OFFICE
EXISTING WALLS AND DOORS
EXISTING WALLS
13'-0"
40'-0"
A
A

NOTES

1. ALL NEW 8' PARTITIONS FLOOR TO CEILING TO BE 2"X4" @ 16" O/C WITH 1/2 SHEET ROCK BOTH SIDES
2. FINISH OF KITCHEN, DOUGH ROOM, STORAGE, MEN'S AND WOMEN'S TOILETS TO BE TWO (2) COATS SEMI-GLOSS ENAMEL LIGHT COLOR.
3. NO STRUCTURAL CHANGES ARE TO BE MADE
4. IN KITCHEN PROVIDE (2) 20-B-C FIRE EXTINGUSHERS.
   IN DINING PROVIDE (2) 2-A-10B-C FIRE EXTINGUSHERS.
5. ALL WOOD PANELING OR DECORATIVE MATERIALS SHALL BE FLAME TREATED.
6. ALL INTERIOR FREE STANDING WALLS COVERED WITH 3/8 PLY ONLY.
7. ALL GLASS TO BE PAINTED ON INTERIOR SURFACE ONLY.
8. FRONT DOORS (8) TO BE COVERED ON BOTH SIDES WITH 3/8 PLY.
9. PAINT INTERIOR SURFACES FROM 8' UP TO AND INCLUDING CEILING WITH DARK PAINT (BLACK).

1371 Kooser Rd

C-1 Zone
B-3 Occupancy 1973 UBC
1 STY + Mezz
TYPE III-N Sprk
Fire Zone 2
Permit # 12341V

DOOR SCHEDULE

NO.	SIZE	TYPE	MISC.
1	4' 2"	SOLID CORE	PANIC HARDWARE CLOSER
2	3°-6°	HOL. CORE	"
3	3°-6°	SOLID CORE	DEAD BOLT LOCK
4	3°-6°	HOL. CORE	NO LOCK CLOSER
5	3°-6°	HOL. CORE	DEAD BOLT LOCK
6	2°-6°	HOL. CORE	CLOSER ← 32" min clr @ Bathrooms
7	EXISTING		ADD DEAD BOLT LOCK
8	"		ADD PANIC HARDWARE

ALL DOORS UNLISTED ARE EXISTING WITH NO CHANGES.

FLOOR PLAN
1/8 = 1'-0" SCALE

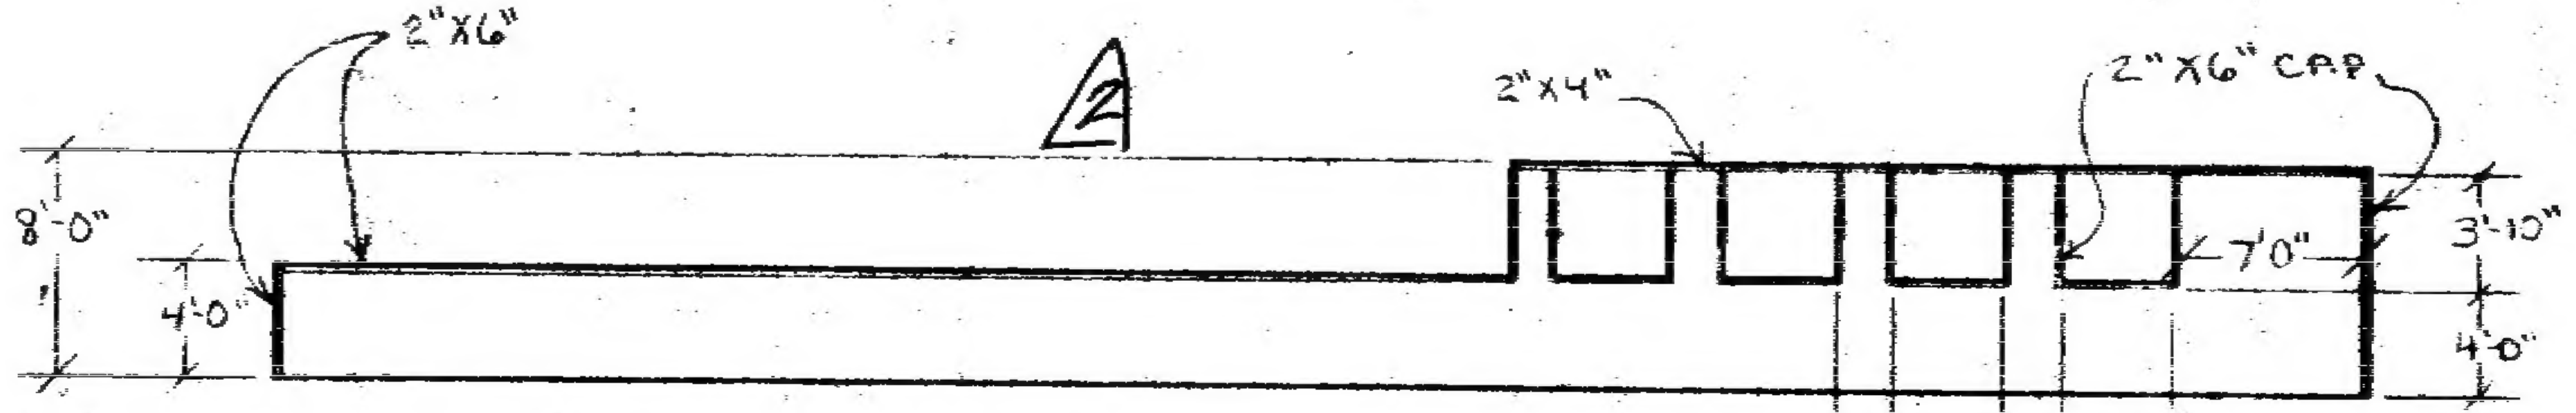

SECTION A-A
WINDOW FRAMING DETAIL

NOTICE TO ALL PERSONS RECEIVING THIS DRAWING
CONFIDENTIAL: Reproduction Forbidden without the specific written permission of Pizza Time Theatre Inc., Mountain View, California. This drawing is only conditionally issued, and neither receipt nor possession thereof confers or transfers any right in, or license to use, the subject matter of the drawing or any design or technical information shown thereon, nor any right to reproduce this drawing or any part thereof, except for manufacture by vendors for Pizza Time Theatre Inc. and for manufacture under the corporation's written license, no right to reproduce this drawing is granted or the subject matter thereof unless by written agreement with or written permission from the corporation.

Change 2

Permit # 12341 ✓

Pizza Time Theatre Inc.
455 N. Bernardo Avenue
Suite A
Mountain View, CA 94043

© 1978 Pizza Time Theatre Inc.

3

BY: DESIGN SERVICES
OF MENLO PARK CA.

REV C
10/25/78

REV. B

P/C 15840 P/C 15840 Revised SHEET

PARTIAL FLOOR PLAN
1/4" = 1'-0"

EQUIPMENT SCHEDULE:

1. STORE ROOM SHELVES
2. WALK-IN REFRIGERATOR
3. WALK-IN SHELVING
4. PRE-MAKE REFRIGERATOR
5. PIZZA TABLES
6. PIZZA OVENS
7. EXHAUST VENTILATORS
8. DOUGH ROLLING TABLE
9. DOUGH ROLLER
10. ORDER COUNTER
11. CASH REGISTERS
12. PIZZA CUTTING TABLES
13. WORK TABLE
14. SLICER
15. MIXER
16. DISHWASHER
17. SOILED & CLEAN TABLES
18. DISPOSER & PRE-RINSE
19. ICE MAKER & BIN
20. SYRUP TANK SHELVES
21. CO2 TANKS
22. [illegible] & CARBONATED DISPENSERS
23. COUNTER / SINK
24. BACK BAR REFRIGERATOR
25. BEER & WINE FAUCETS
26. YOGURT MACHINES
27. COFFEE MAKER
28. WALK-IN REFRIGERATOR
29. WALK-IN SHELVING
30. SALAD BAR
31. ROLL-A-GRILL
32. SINK

PIZZA TIME THEATRE
SAN JOSE, CA.

REV
9

P/C 15480

ELECTRICAL PANELS
ELECT. OUTLET FOR (2) 100 WATT LIGHTS & BLOWER CKT. 115/60/1
PLUG + 3'-6" 115/60/1
CON. DRAINS TO F.S.
FLOOR SINK
(2) 3/4" GAS 280,000 BTU.
PLUGS (2) 1/2 HP. + 12" 115/60/1
(2) 3/4" GAS 280,000 BTU
(2) 3/4" GAS 280,000 BTU
(2) 3/4" GAS 280,000 BTU
SEE DETAIL THIS SHEET FOR EXHAUST VENT. & DUCTS TO BAKE OVENS
PLUG 1 HP. + 4'-0" 208/60/3 ∅
PLUG 1.7 KW. + 60" 115/60/1
PLUG + 12" 115/60/1
SWITCHES & PILOT LIGHTS TO EXHAUST FANS ON ROOF
PLUG + 3'-3" 115/60/1 SEPARATE CKT WITH GRD FOR EACH PLUG
PLUG 1.7 KW. + 60" 115/60/1
PLUG + 12" 115/60/1
1 1/2" WASTE
1 1/2 HP PROVIDE CORD & PLUG +12" 208/60/3∅
1/2" COLD WATER + 12" BRANCH TO ICE MAKERS
1/2" HOT WATER + 12"
1 1/2" WASTE + 12"
1/2" HOT WATER + 12"
1/2" COLD WATER + 12"
3/4 HP + 12" 208/60/1∅
1 1/2 HP. PROVIDE CORD & PLUG + 12" 208/60/3 ∅
(2) 1 HP + 72" 208/60/1 ∅
3/4" HOT WATER + 12"
(2) 1-HP MOTORS & SLW HEATER + 12" 208/60/3 ∅
2" WASTE TO F.S.
PLUG 1.7 KW. 115/60/1
FLOOR SINK
PLUG + 18" 115/60/1
PLUG + 3'-3" 115/60/1 SEPARATE CKT WITH GRD
CON. DRAINS TO F.S.
FLOOR SINK
1/2" HOT WATER + 12"
1/2" COLD WATER + 12" BRANCH TO CARBONATORS
PLUG + 3'-3" 115/60/1 SEPARATE CKT WITH GRD
PLUG + 18" 115/60/1
CON. DRAINS TO F.S.
(2) PLUGS 3/4 HP + 5'-6" 115/60/1
ELECT. OUTLET FOR (2) 100 WATT LIGHTS & BLOWER CKT. 115/60/1
PLUG + 12" 115/60/1
FLOOR SINK
OPENINGS IN ROOF TO VENT TO BE PROPERLY FRAMED WITH HEADERS.
EXHAUST FAN 4000 CFM
FLASHING
6" HIGH CURB
EXIST. ROOF
3" MIN.
PROVIDE 1-HR. SHEET ROCK ENCLOSURE
DUCT 18" DIA.
DUCT
EXHAUST VENTILATORS
PIZZA OVENS
SECTION THRU OVEN EXHAUST SYSTEMS
2
3

MECHANICAL, ELECTRICAL + PLUMBING FOR FOOD SERVICE EQUIPMENT

12341

5

PIZZA TIME THEATRE
SAN JOSE, CA

REV
10/25

P/C 15480

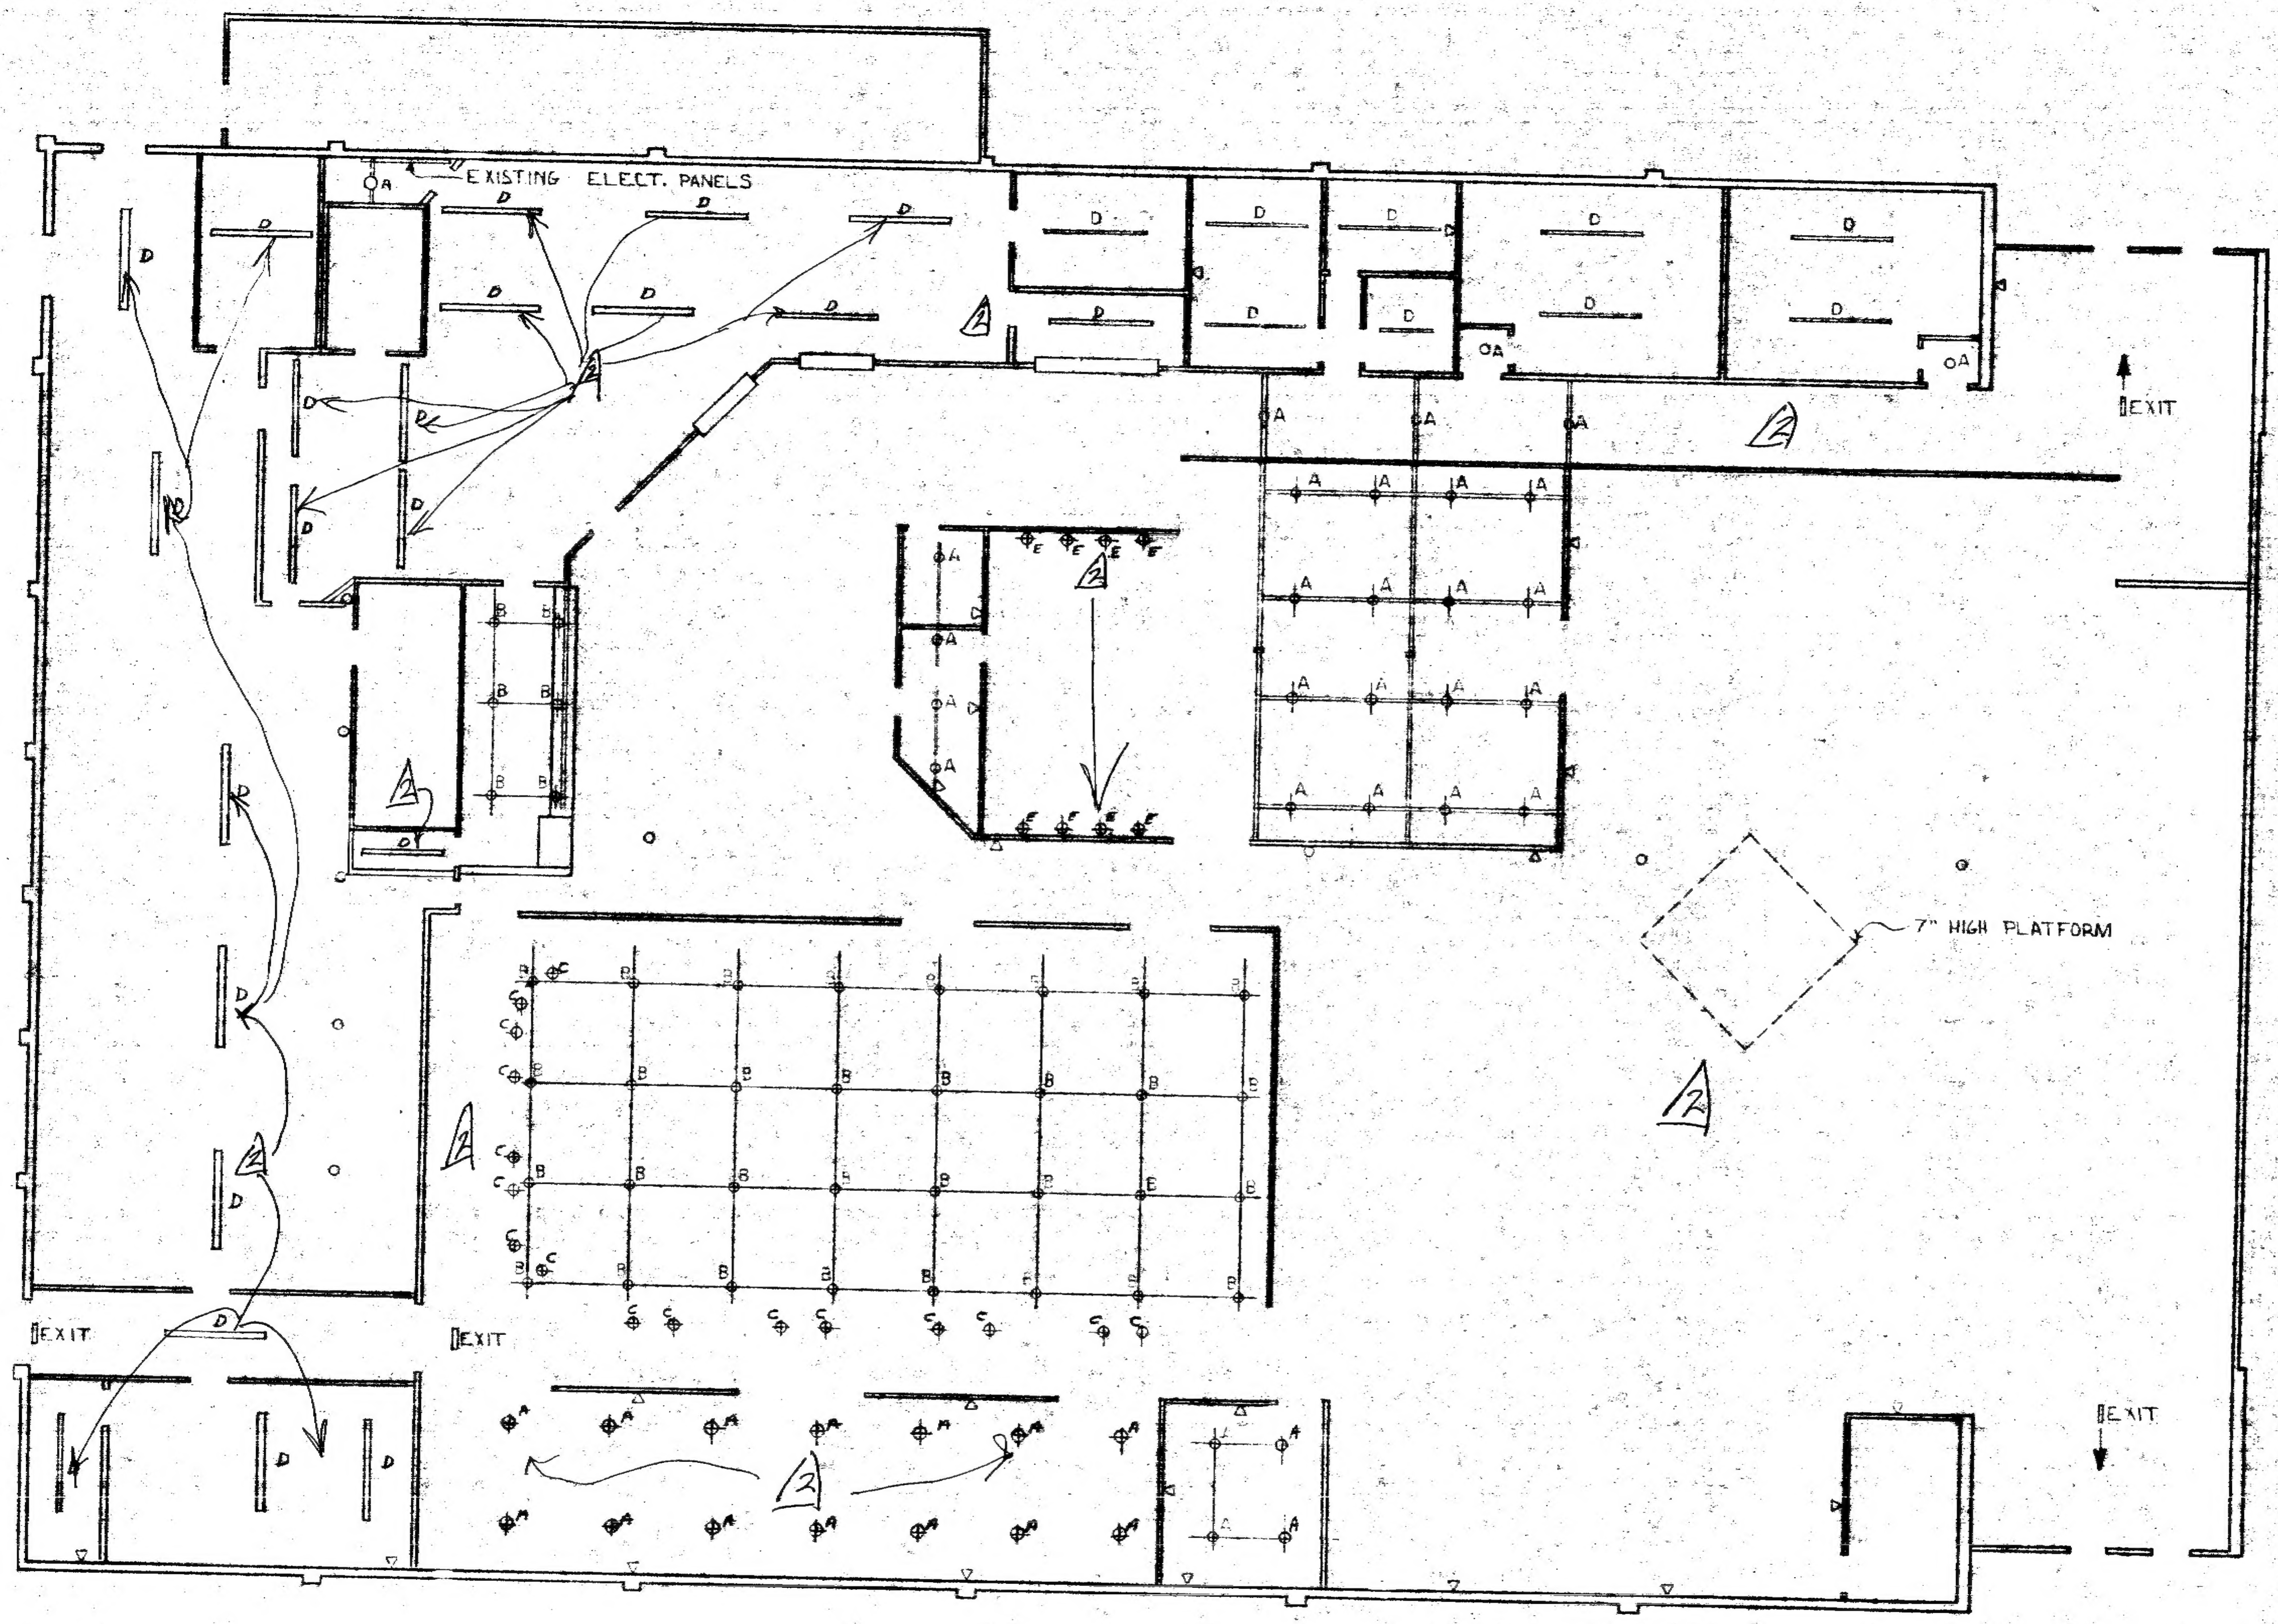

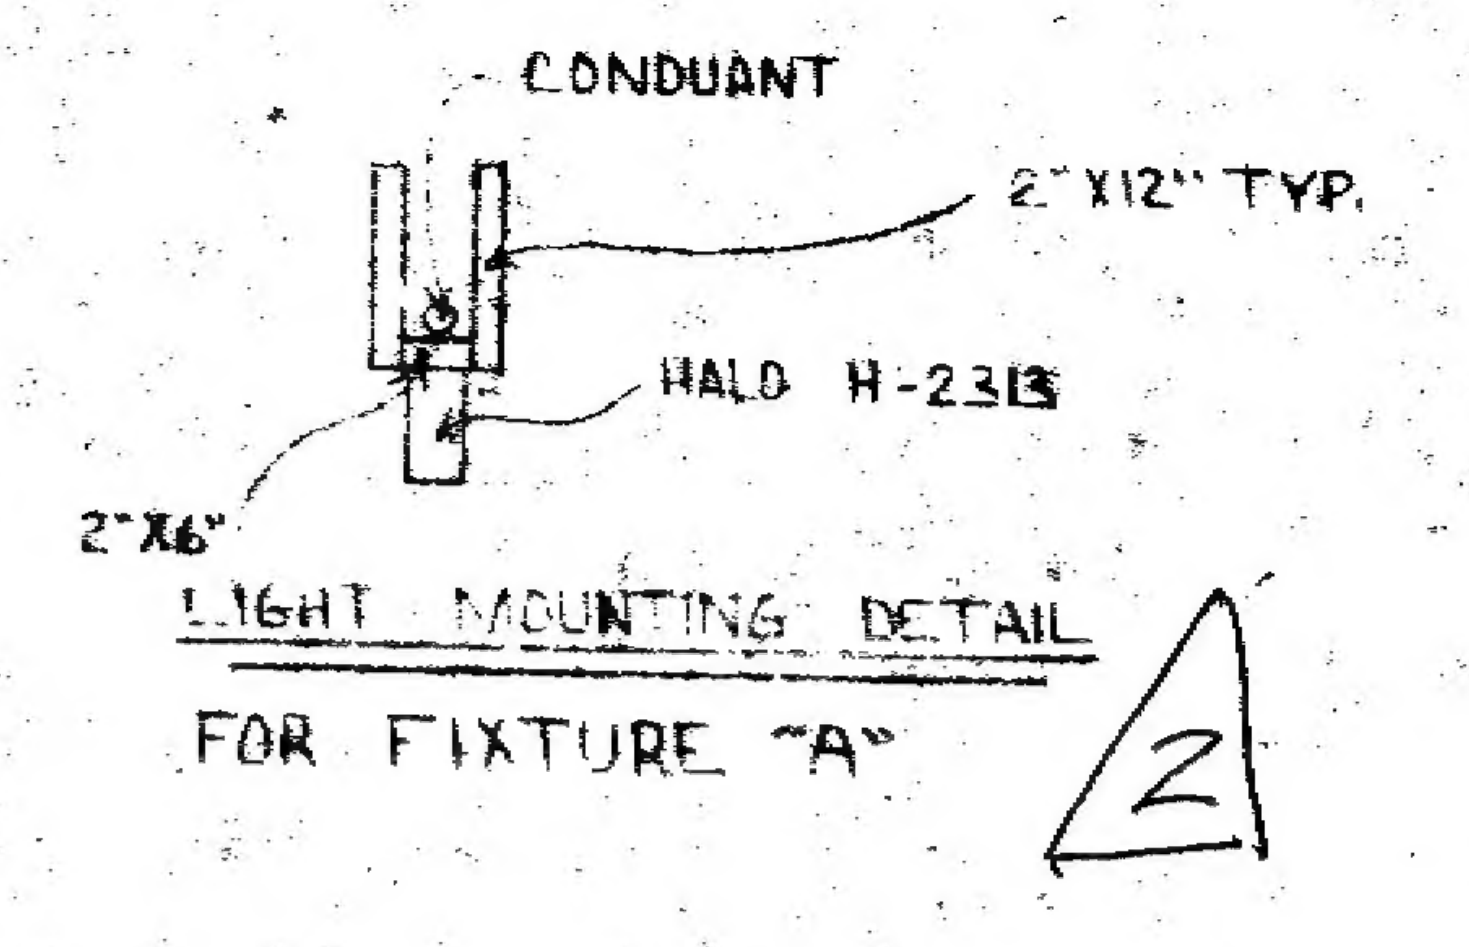

LIGHT MOUNTING DETAIL
FOR FIXTURE "A" 2

FIXTURE SCHEDULE

A. HALO H-2313 SURFACE MOUNT CYLINDER, 75 WATT R-30 LAMPS.

2 B. HALO H-2313 TO BE HUNG AT 12'-0" WITH TUBULAR SUPPORT HANGERS.

2 C. HALO L 373 CANOPY ADAPTER FOR PENDANT MOUNT HUNG AT 13' 0", 4'-0" LONG RUN TO INDIVIDUAL SWITCHES PROVIDE (24) LIGHTS

D. SURFACE MOUNT (2) LIGHT FLOURESCENT FIXTURES, SWITCH TO PANEL.

▽ WHERE SHOWN PROVIDE 20 AMP 115/60/1Ø PLUG OUTLET, IN WALL 12" UP FROM FLOOR. IN FLOOR PROVIDE FLUSH SCREW COVER.

PROVIDE EXIT & EMERGENCY LIGHTS AS REQUIRED BY THE FIRE MARSHALL.

EXITING LIGHTING TO REMAIN FOR ALL AREAS. RELAMP AS DIRECTED BY OWNER.

2 E. HALO L512 SURFACE MOUNT 7'-0" FROM FLOOR.

6

12341

Pizza Time Theatre Inc.
455 N. Bernardo Avenue
Suite A
Mountain View, CA 94043

© 1978 Pizza Time Theatre Inc.

NOTICE TO ALL PERSONS RECEIVING THIS DRAWING CONFIDENTIAL: Reproduction forbidden without the specific written permission of Pizza Time Theatre Inc., Mountain View, California. This drawing is only conditionally issued, and neither receipt nor possession thereof confers or transfers any right in, or license to use, the subject matter of the drawing or any design or technical information shown thereon, nor any right to reproduce this drawing or any part thereof, except for manufacture by vendors for Pizza Time Theatre Inc. and for manufacture under the corporation's written license. No right to reproduce this drawing is granted or the subject matter thereof unless by written agreement with or written permission from the corporation.

DRAWN BY: [illegible]
REV B
TITLE:
SCALE: [illegible]
SHEET [illegible]

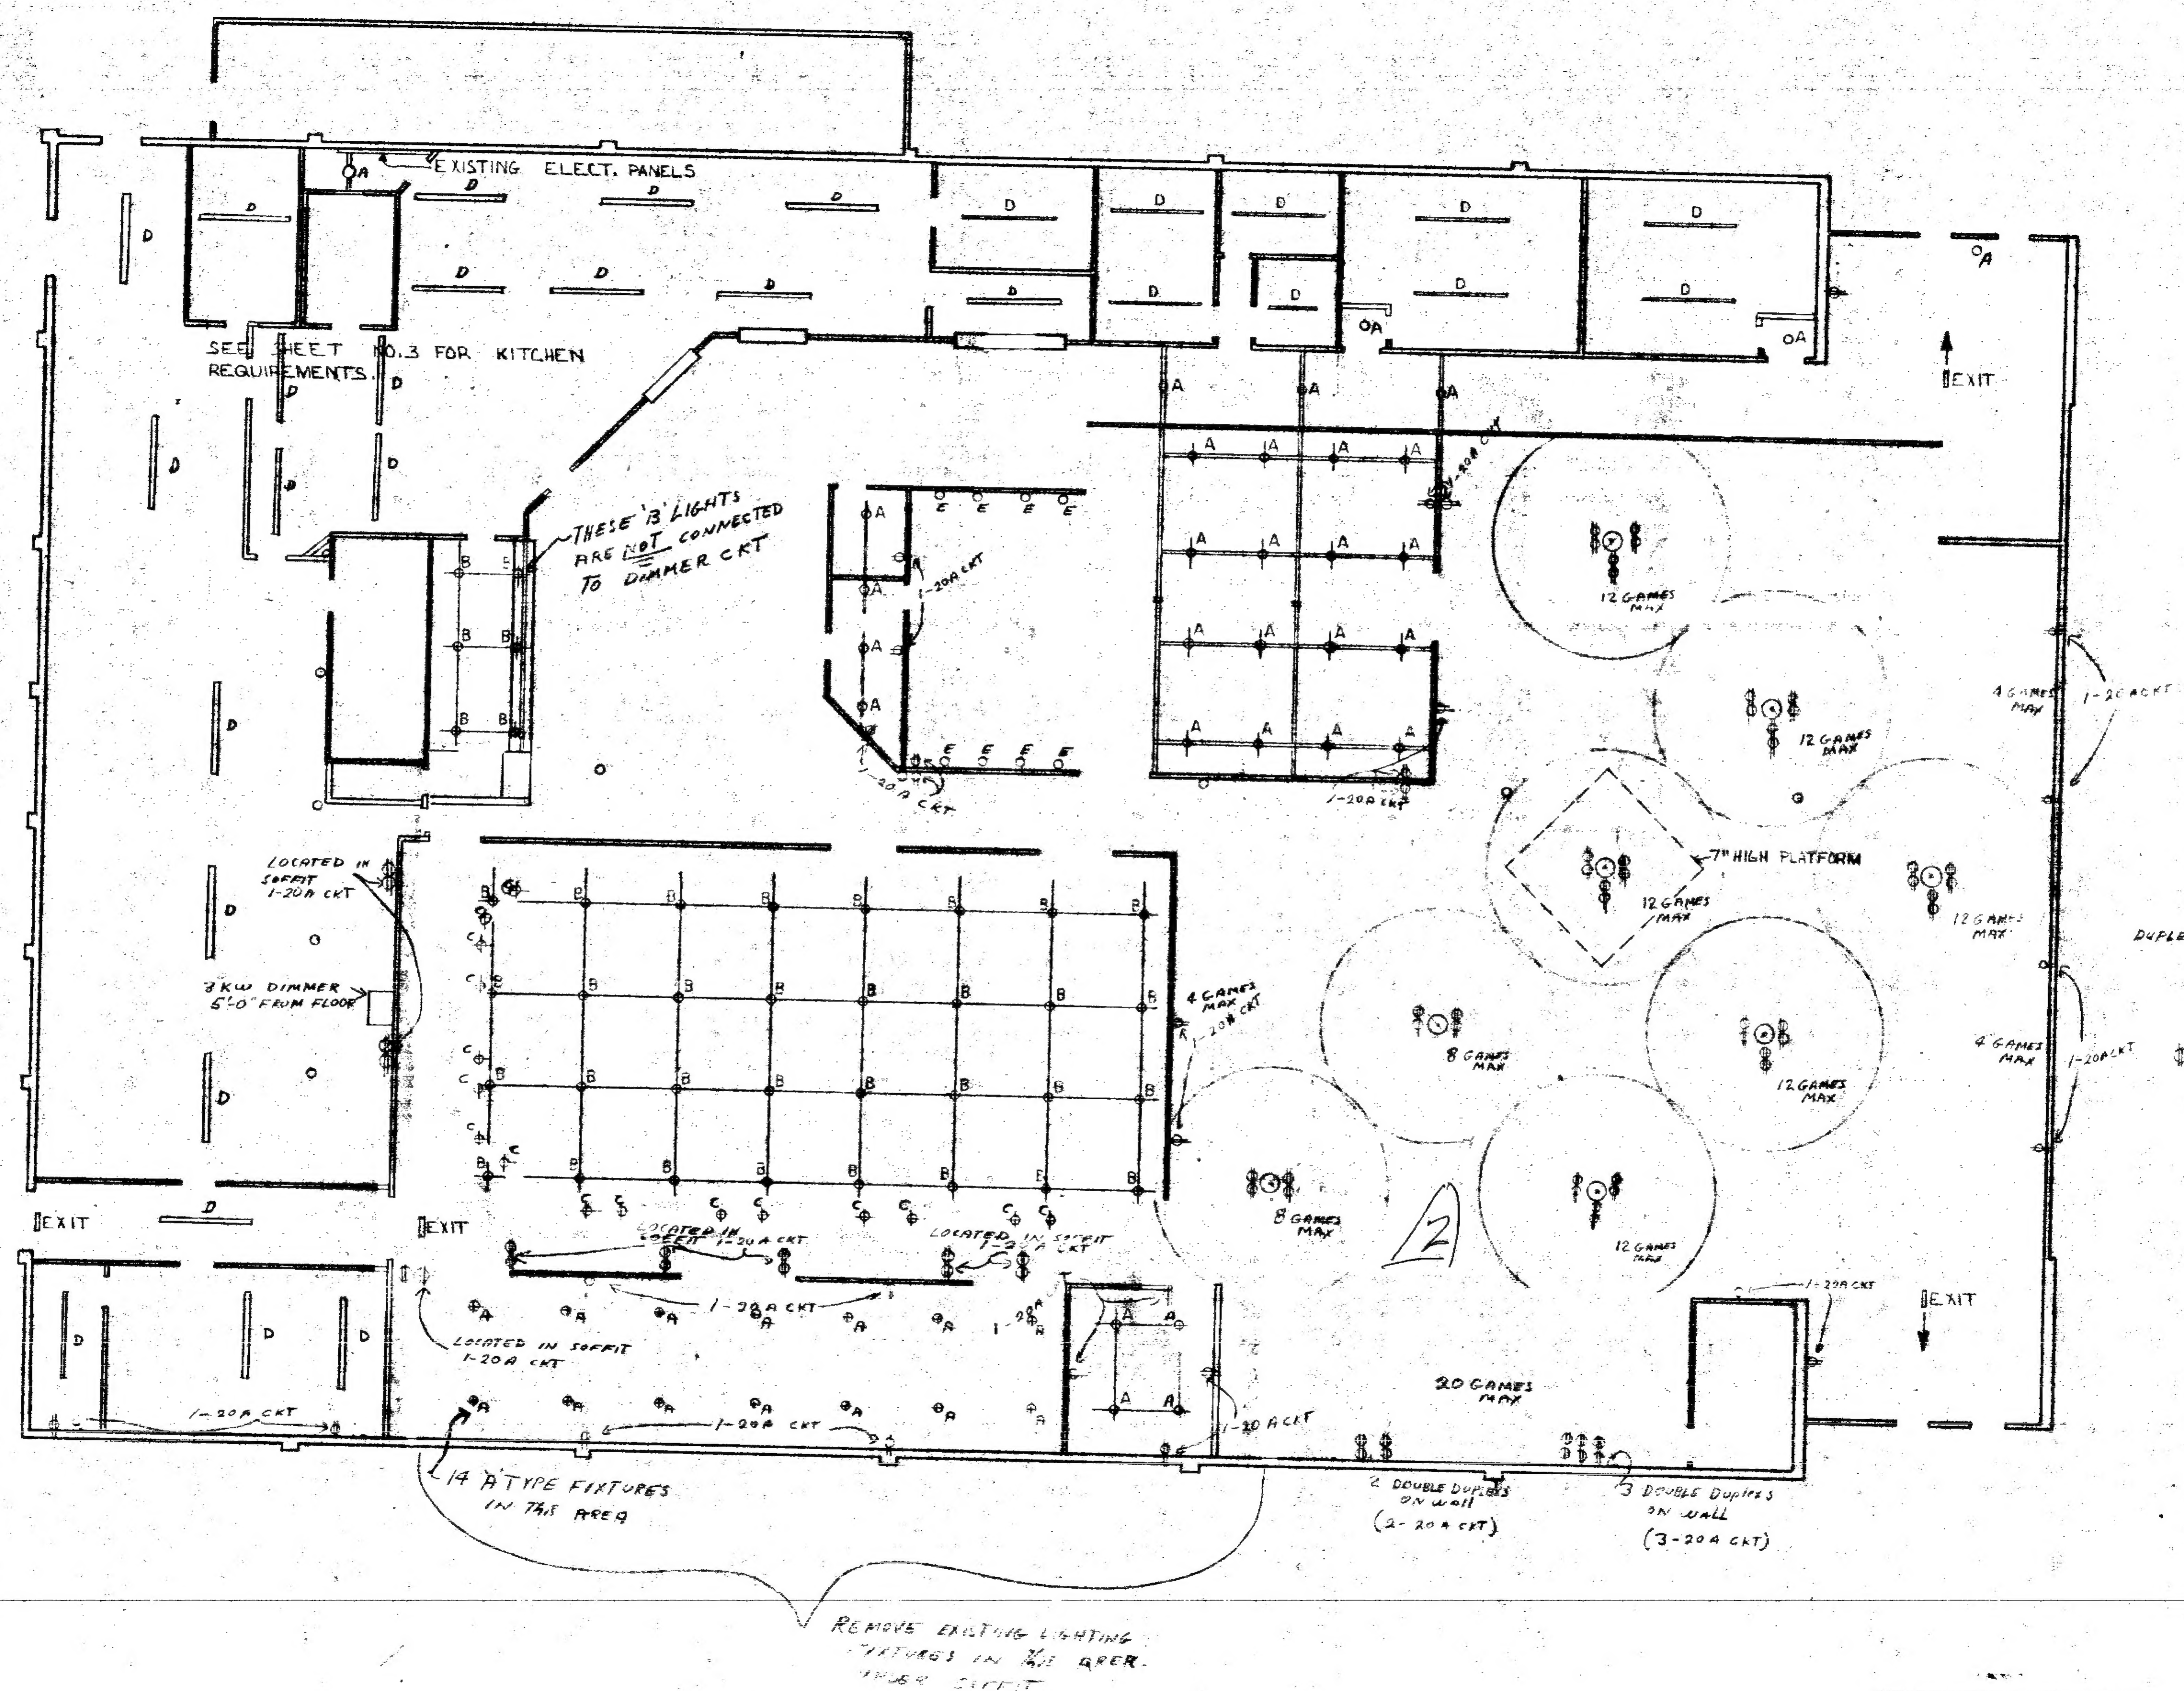
EXISTING ELECT. PANELS
SEE SHEET NO.3 FOR KITCHEN REQUIREMENTS.
THESE 'B' LIGHTS ARE NOT CONNECTED TO DIMMER CKT
LOCATED IN SOFFIT 1-20A CKT
3KW DIMMER 5'-0" FROM FLOOR
7" HIGH PLATFORM
12 GAMES MAX
8 GAMES MAX
4 GAMES MAX
20 GAMES MAX
1-20A CKT
EXIT
LOCATED IN SOFFIT 1-20A CKT
14 'A' TYPE FIXTURES IN THIS AREA
2 DOUBLE DUPLEXES ON WALL (2-20A CKT)
3 DOUBLE DUPLEXES ON WALL (3-20A CKT)
REMOVE EXISTING LIGHTING FIXTURES IN THE AREA UNDER SOFFIT
A
B
C
D
E
2

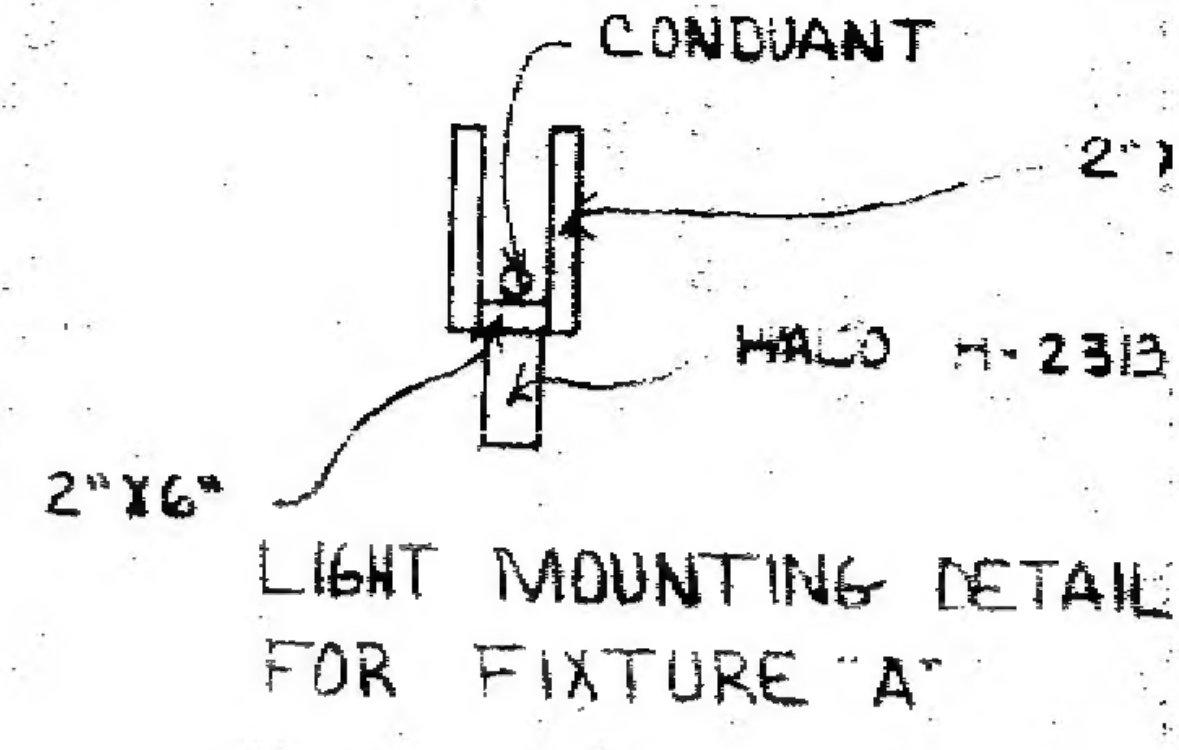

LIGHT MOUNTING DETAIL FOR FIXTURE "A"

FIXTURE SCHEDULE

A. HALO H-2313 SURFACE MOUNT CY
75 WATT R-30 LAMPS.

B. HALO H-2313 TO BE HUNG AT
12'-0" WITH TUBULAR SUPPORT AN

C. HALO L973 CANOPY ADAPTER FOR PENDA
HUNG AT 12'-0", 4'-0" LONG RUN TO
INDIVIDUAL SWITCHES PROVIDE (24)

D. SURFACE MOUNT (2) LIGHT FLOURES
FIXTURES, SWITCH TO PANEL.

⦶ WHERE SHOWN PROVIDE 20 AMP
DUPLEX PLUG OUTLET, IN WALL 12" UP
FLOOR.

PROVIDE EXIT & EMERGENCY L
AS REQUIRED BY THE FIRE M

⦶⦶ WHERE SHOWN PROVIDE 20 AMP 11
DOUBLE DUPLEX OUTLET, IN WALL
PIPE 12" UP FROM FLOOR

EXITING LIGHTING TO REMAIN FO
AREAS. RELAMP AS DIRECTED B

E. HALO L512 SURFACE MOUNT 30"

7

Pizza Time Theatre Inc.
455 N. Bernardo Avenue
Suite A
Mountain View, CA 940

© [illegible] Pizza Time Theatre Inc.

2

NOTICE TO ALL PERSONS RECEIVING THIS DRAWING
CONFIDENTIAL: Reproduction Forbidden without the specific written permission of Pizza Time Theatre Inc., Mountain View, California. This drawing is only conditionally issued, and neither receipt nor possession thereof confers or transfers any right in, or license to use, the subject matter of the drawing or any design or technical information shown thereon, nor any right to reproduce this drawing or any part thereof, except for manufacture by vendors for Pizza Time Theatre Inc. and for manufacture under the corporation's [illegible], no right to reproduce this drawing is granted or the subject matter thereof unless by written agreement with or written permission from the corporation.

DRAWN BY: [illegible]
[illegible]
SCALE: [illegible]
SHEET [illegible]

	S/Q FT.	SEATS	PARKING
THEATRE DINING	2368	152	60.8
ADULT DINING	1254	67	26.8
PRIVATE DINING	840	40	16.0
TOTALS	4142	259	103.6

WOMENS
PROVIDE (5) WATER CLOSETS, (3) LAVARTORIES, MIRRORS, SOAP DISPENSERS TOWEL DISPENSERS ONE TOILET ENCLOSURE TO HAVE 2'-8" DOOR AND GRAB BARS.

MENS
PROVIDE 2 WATER CLOSETS 3 URINALS 3 LAVATORIES MIRRORS SOAP DISP. TOWEL DISPENSERS ONE TOILET ENCLOSURE TO HAVE 2'-8" DOOR AND GRAB BARS.

HANDICAPED REQUIREMENTS TO BE U.B.C. §1711

SAN JOSE
CITY PLANNING
☑ APPROVED
☐ ~~DENIED~~
SUBJECT TO CONDITIONS
CP78-5.28
R Mason

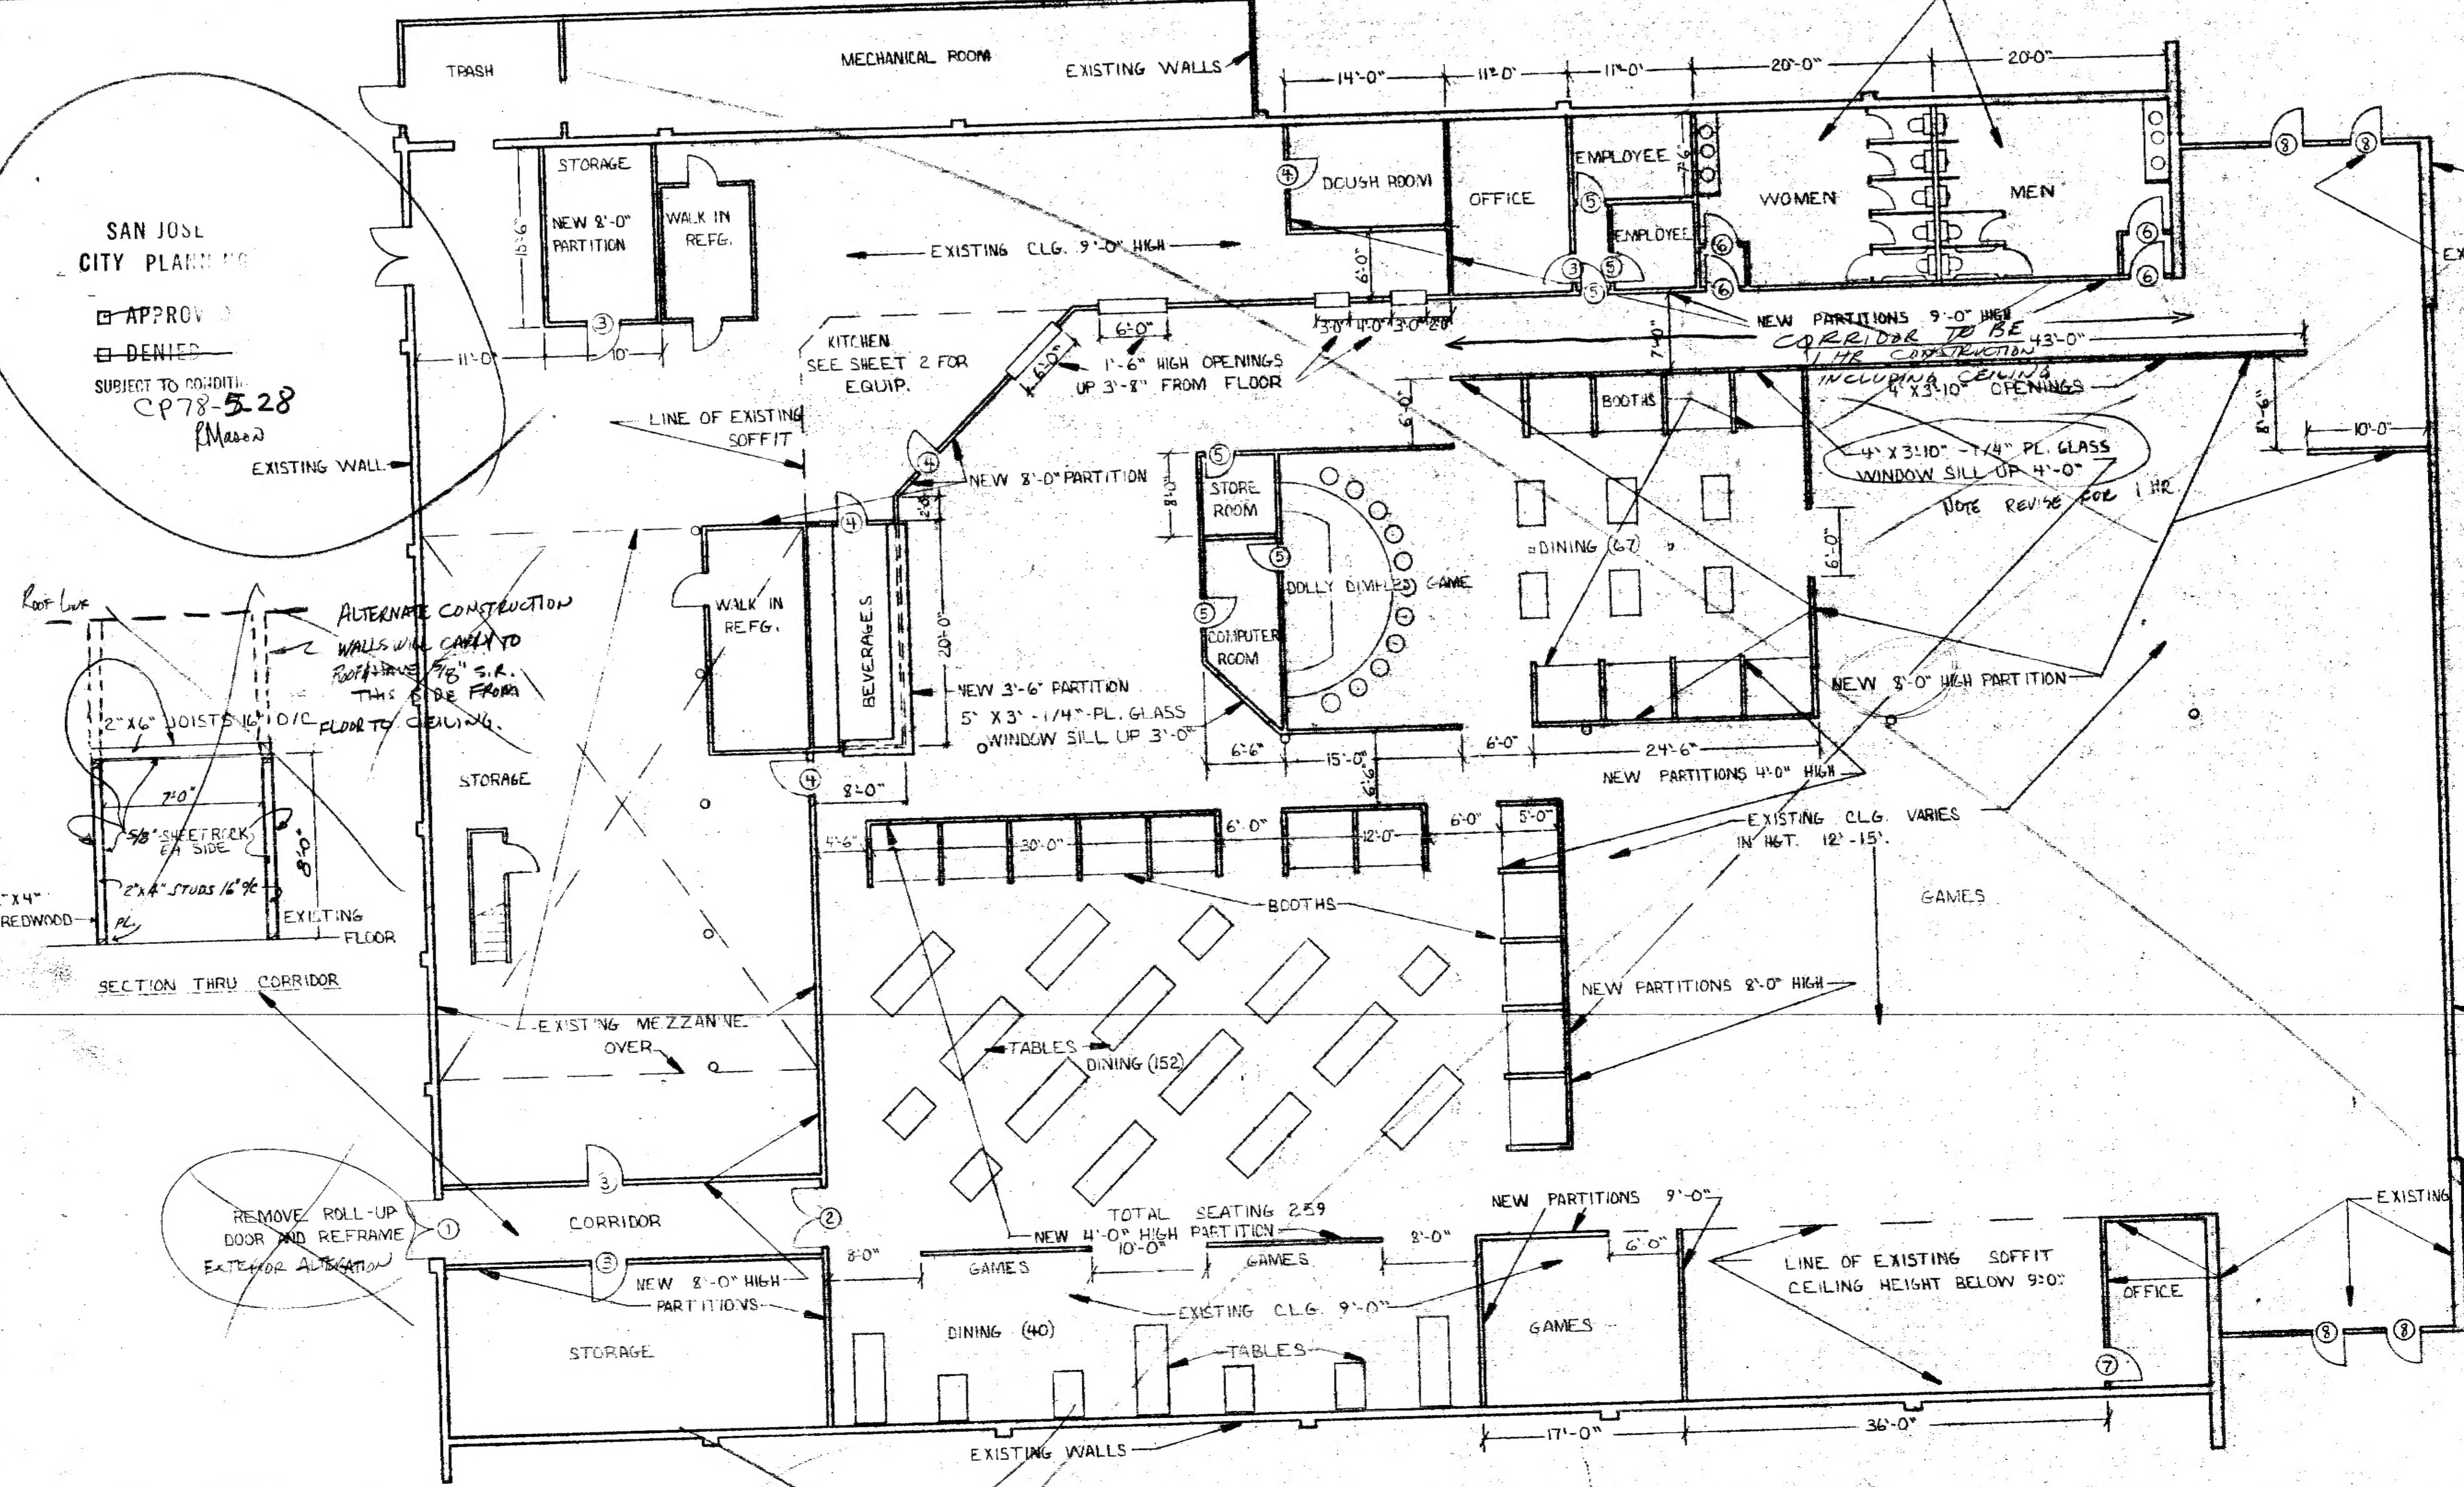

NOTES
1. ALL NEW PARTITIONS TO BE 2"X4" @16" O/C WITH 5/8 SHEET ROCK BOTH SIDES.
2. FINISH OF KITCHEN, DOUGH ROOM, STORAGE, MENS AND WOMENS TOILETS TO BE TWO (2) COATS SEMI-GLOSS ENAMEL LIGHT COLOR.
3. NO STRUCTURAL CHANGES ARE TO BE MADE.
4. IN KITCHEN PROVIDE (2) 20-B-C FIRE EXTINGUSHERS.
IN DINING PROVIDE (2) 2-A-10B-C FIRE EXTINGUSHERS.
5. ALL WOOD PANELING OR DECORATIVE MATERIALS SHALL BE FLAME TREATED.

NOT REQ'D FOR PREVIOUSLY CONDITIONED
~~ELECTRICAL & PLUMBING/MECH PERMITS REQ'D. TITLE 24 ENERGY REQUIREMENTS MUST BE MET. SUBMIT CALCULATIONS TO ELEC & PLUMBING/MECH SECTIONS.~~

12341

SUPERSEDED
ORIGINAL
SEE REVISED 2
10/27/78

DOOR SCHEDULE

NO.	SIZE	TYPE	MISC.
1.	3'0"-6'8"	SOLID CORE	PANIC HARDWARE CLOSER
2.	3'0"-6'8"	HOL. CORE	" "
3.	3'0"-6'8"	SOLID CORE	DEAD BOLT LOCK w/ CLOSER
4.	3'0"-6'8"	HOL. CORE	NO LOCK CLOSER
5.	3'0"-6'8"	HOL. CORE	DEAD BOLT LOCK w/ CLOSER
6.	2'0"-6'8"	HOL. CORE	CLOSER w/ CLOSER
7.	EXISTING		ADD DEAD BOLT LOCK
8.	"		ADD PANIC HARDWARE

ALL DOORS UNLISTED ARE EXISTING WITH NO CHANGES.

ALL CORRIDOR DOORS TO HAVE 20 MIN LABEL ASSEMBLY WITH CLOSERS

FLOOR PLAN
1/8" = 1'-0" SCALE

NOTICE TO ALL PERSONS RECEIVING THIS DRAWING
CONFIDENTIAL: Reproduction Forbidden without the specific written permission of Pizza Time Theatre Inc., Mountain View, California. This drawing is only conditionally issued, and neither receipt nor possession thereof confers or transfers any right in, or license to use, the subject matter of the drawing or any design or technical information shown thereon, nor any right to reproduce this drawing or any part thereof, except for manufacture by vendors for Pizza Time Theatre Inc. and for manufacture under the corporation's written license, no right to reproduce this drawing is granted or the subject matter thereof unless by written agreement with or written permission from the corporation.

Pizza Time Theatre Inc.
455 N. Bernardo Avenue
Suite A
Mountain View, CA 94043

© 1978 Pizza Time Theatre Inc.

12341

BY: DESIGN SERVICES
OF MENLO PARK CA.

8

SHEET ONE

BLDG DEPT COPY

P/C 15840

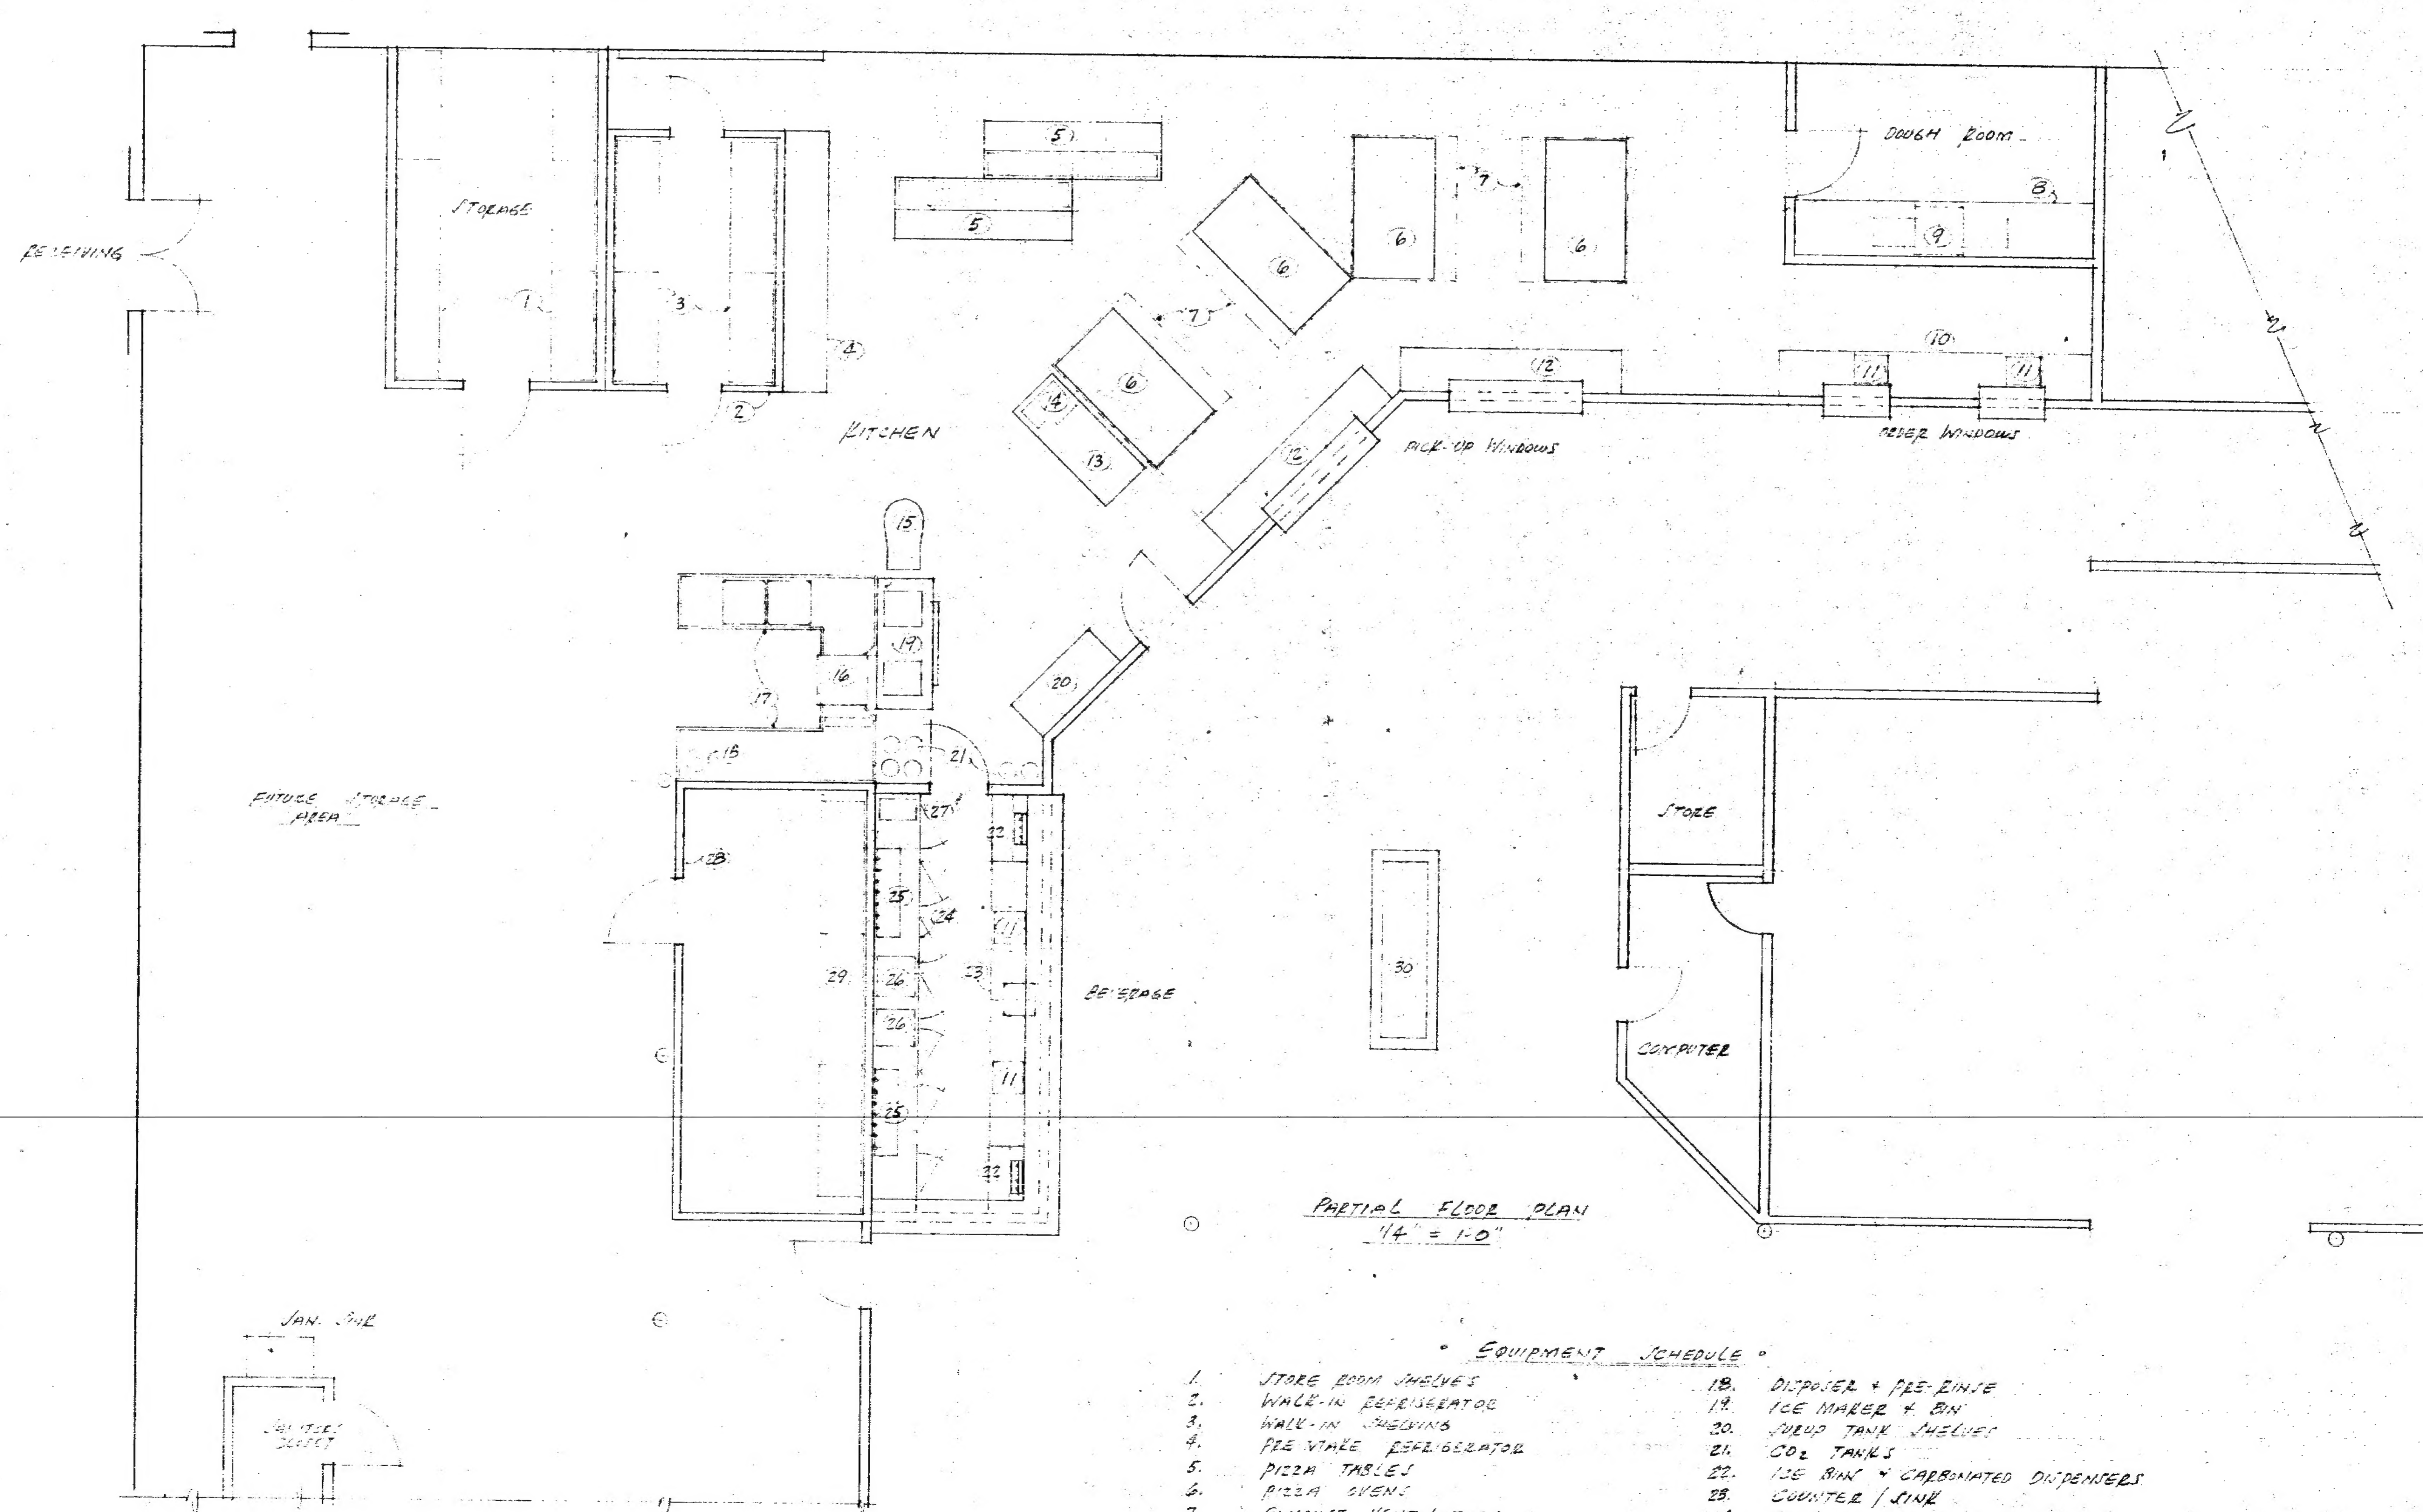

PARTIAL FLOOR PLAN
1/4" = 1'-0"

• EQUIPMENT SCHEDULE •

1. STORE ROOM SHELVES
2. WALK-IN REFRIGERATOR
3. WALK-IN SHELVING
4. PRE-MAKE REFRIGERATOR
5. PIZZA TABLES
6. PIZZA OVENS
7. EXHAUST VENTILATORS
8. DOUGH ROLLING TABLE
9. DOUGH ROLLER
10. ORDER COUNTER
11. CASH RESISTERS
12. PIZZA CUTTING TABLES
13. WORK TABLE
14. SLICER
15. MIXER
16. DISHWASHER
17. SOILED + CLEAN TABLES
18. DISPOSER + PRE-RINSE
19. ICE MAKER + BIN
20. SYRUP TANK SHELVES
21. CO_2 TANKS
22. ICE BIN + CARBONATED DISPENSERS
23. COUNTER / SINK
24. BACK BAR REFRIGERATOR
25. BEER + WINE FAUSETS
26. YOGURT MACHINES
27. COFFEE MAKER
28. WALK-IN REFRIGERATOR
29. WALK-IN SHELVING
30. SALAD BAR

SUPERSEDED
10/27/78
ORIGINAL
SEE REVISED 2

9

PIZZA TIME THEATRE
SAN JOSE, CA.

BY

DESIGN SERVICES
MENLO PARK, CA

SHEET NO 2

12341

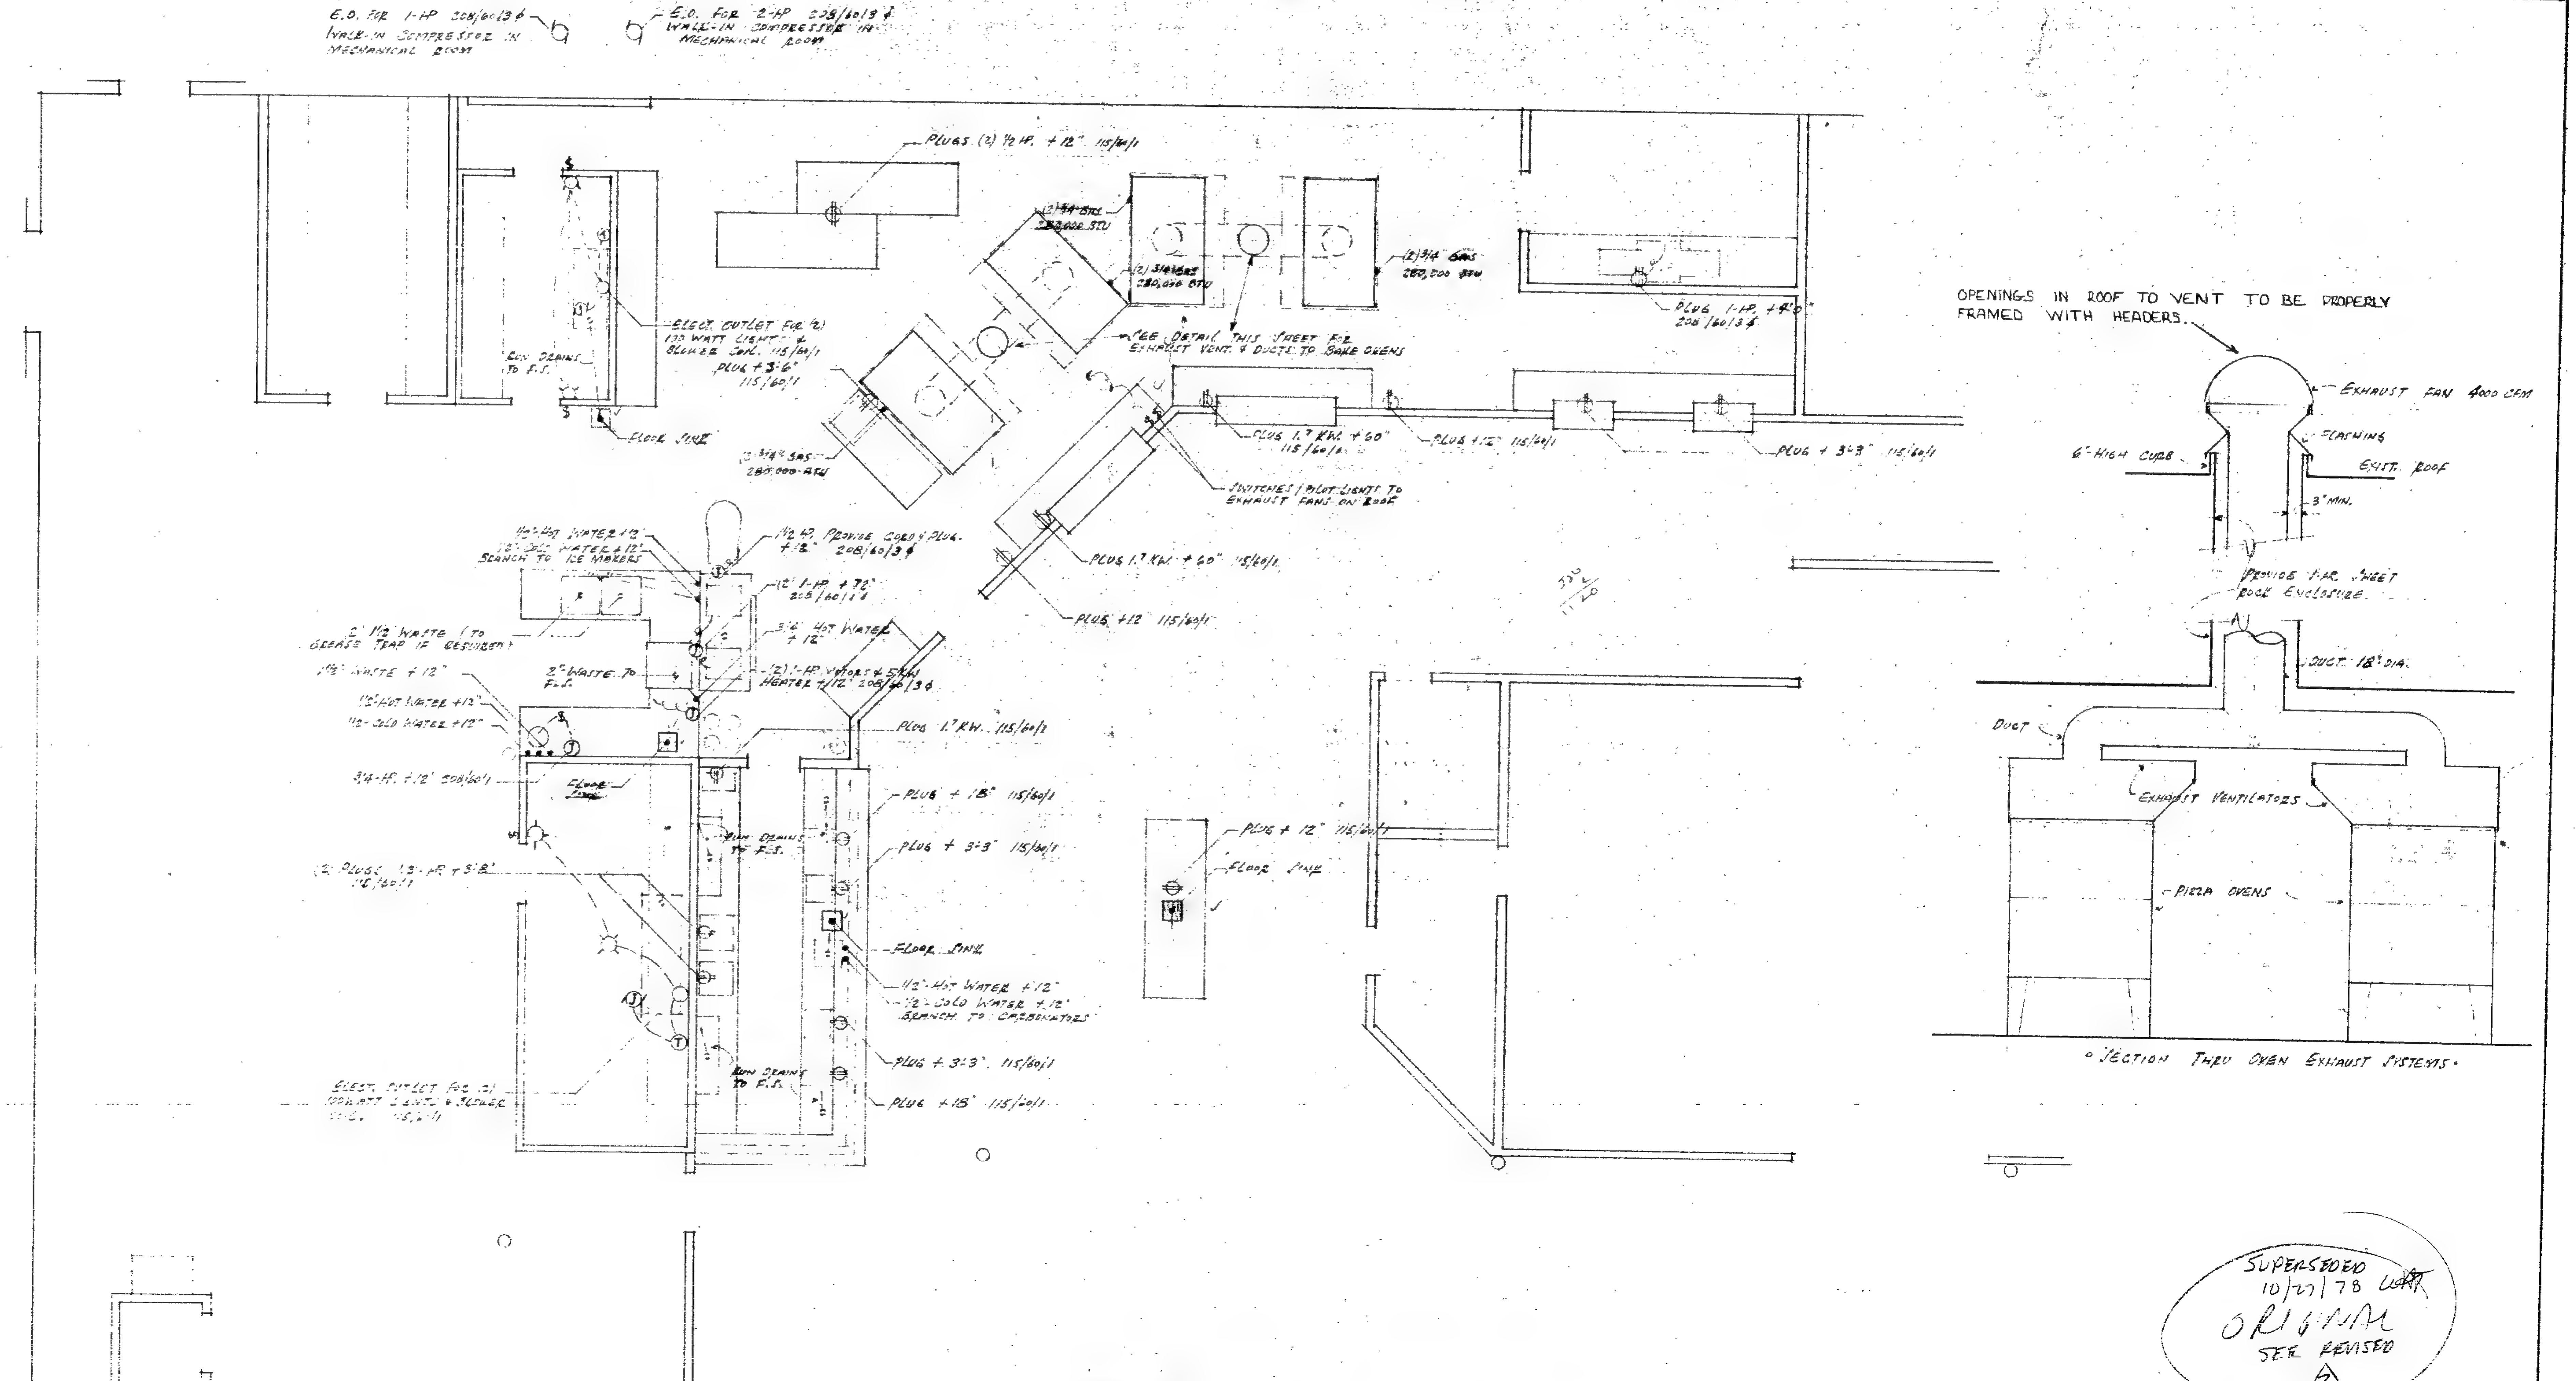

MECHANICAL, ELECTRICAL & PLUMBING FOR
FOOD SERVICE EQUIPMENT

SUPERSEDED
10/27/78 LWT
ORIGINAL
SEE REVISED
2

10

PIZZA TIME THEATRE
SAN JOSE, CA.

BY

DESIGN SERVICES
MENLO PARK CA.

SHEET No. 3

12341

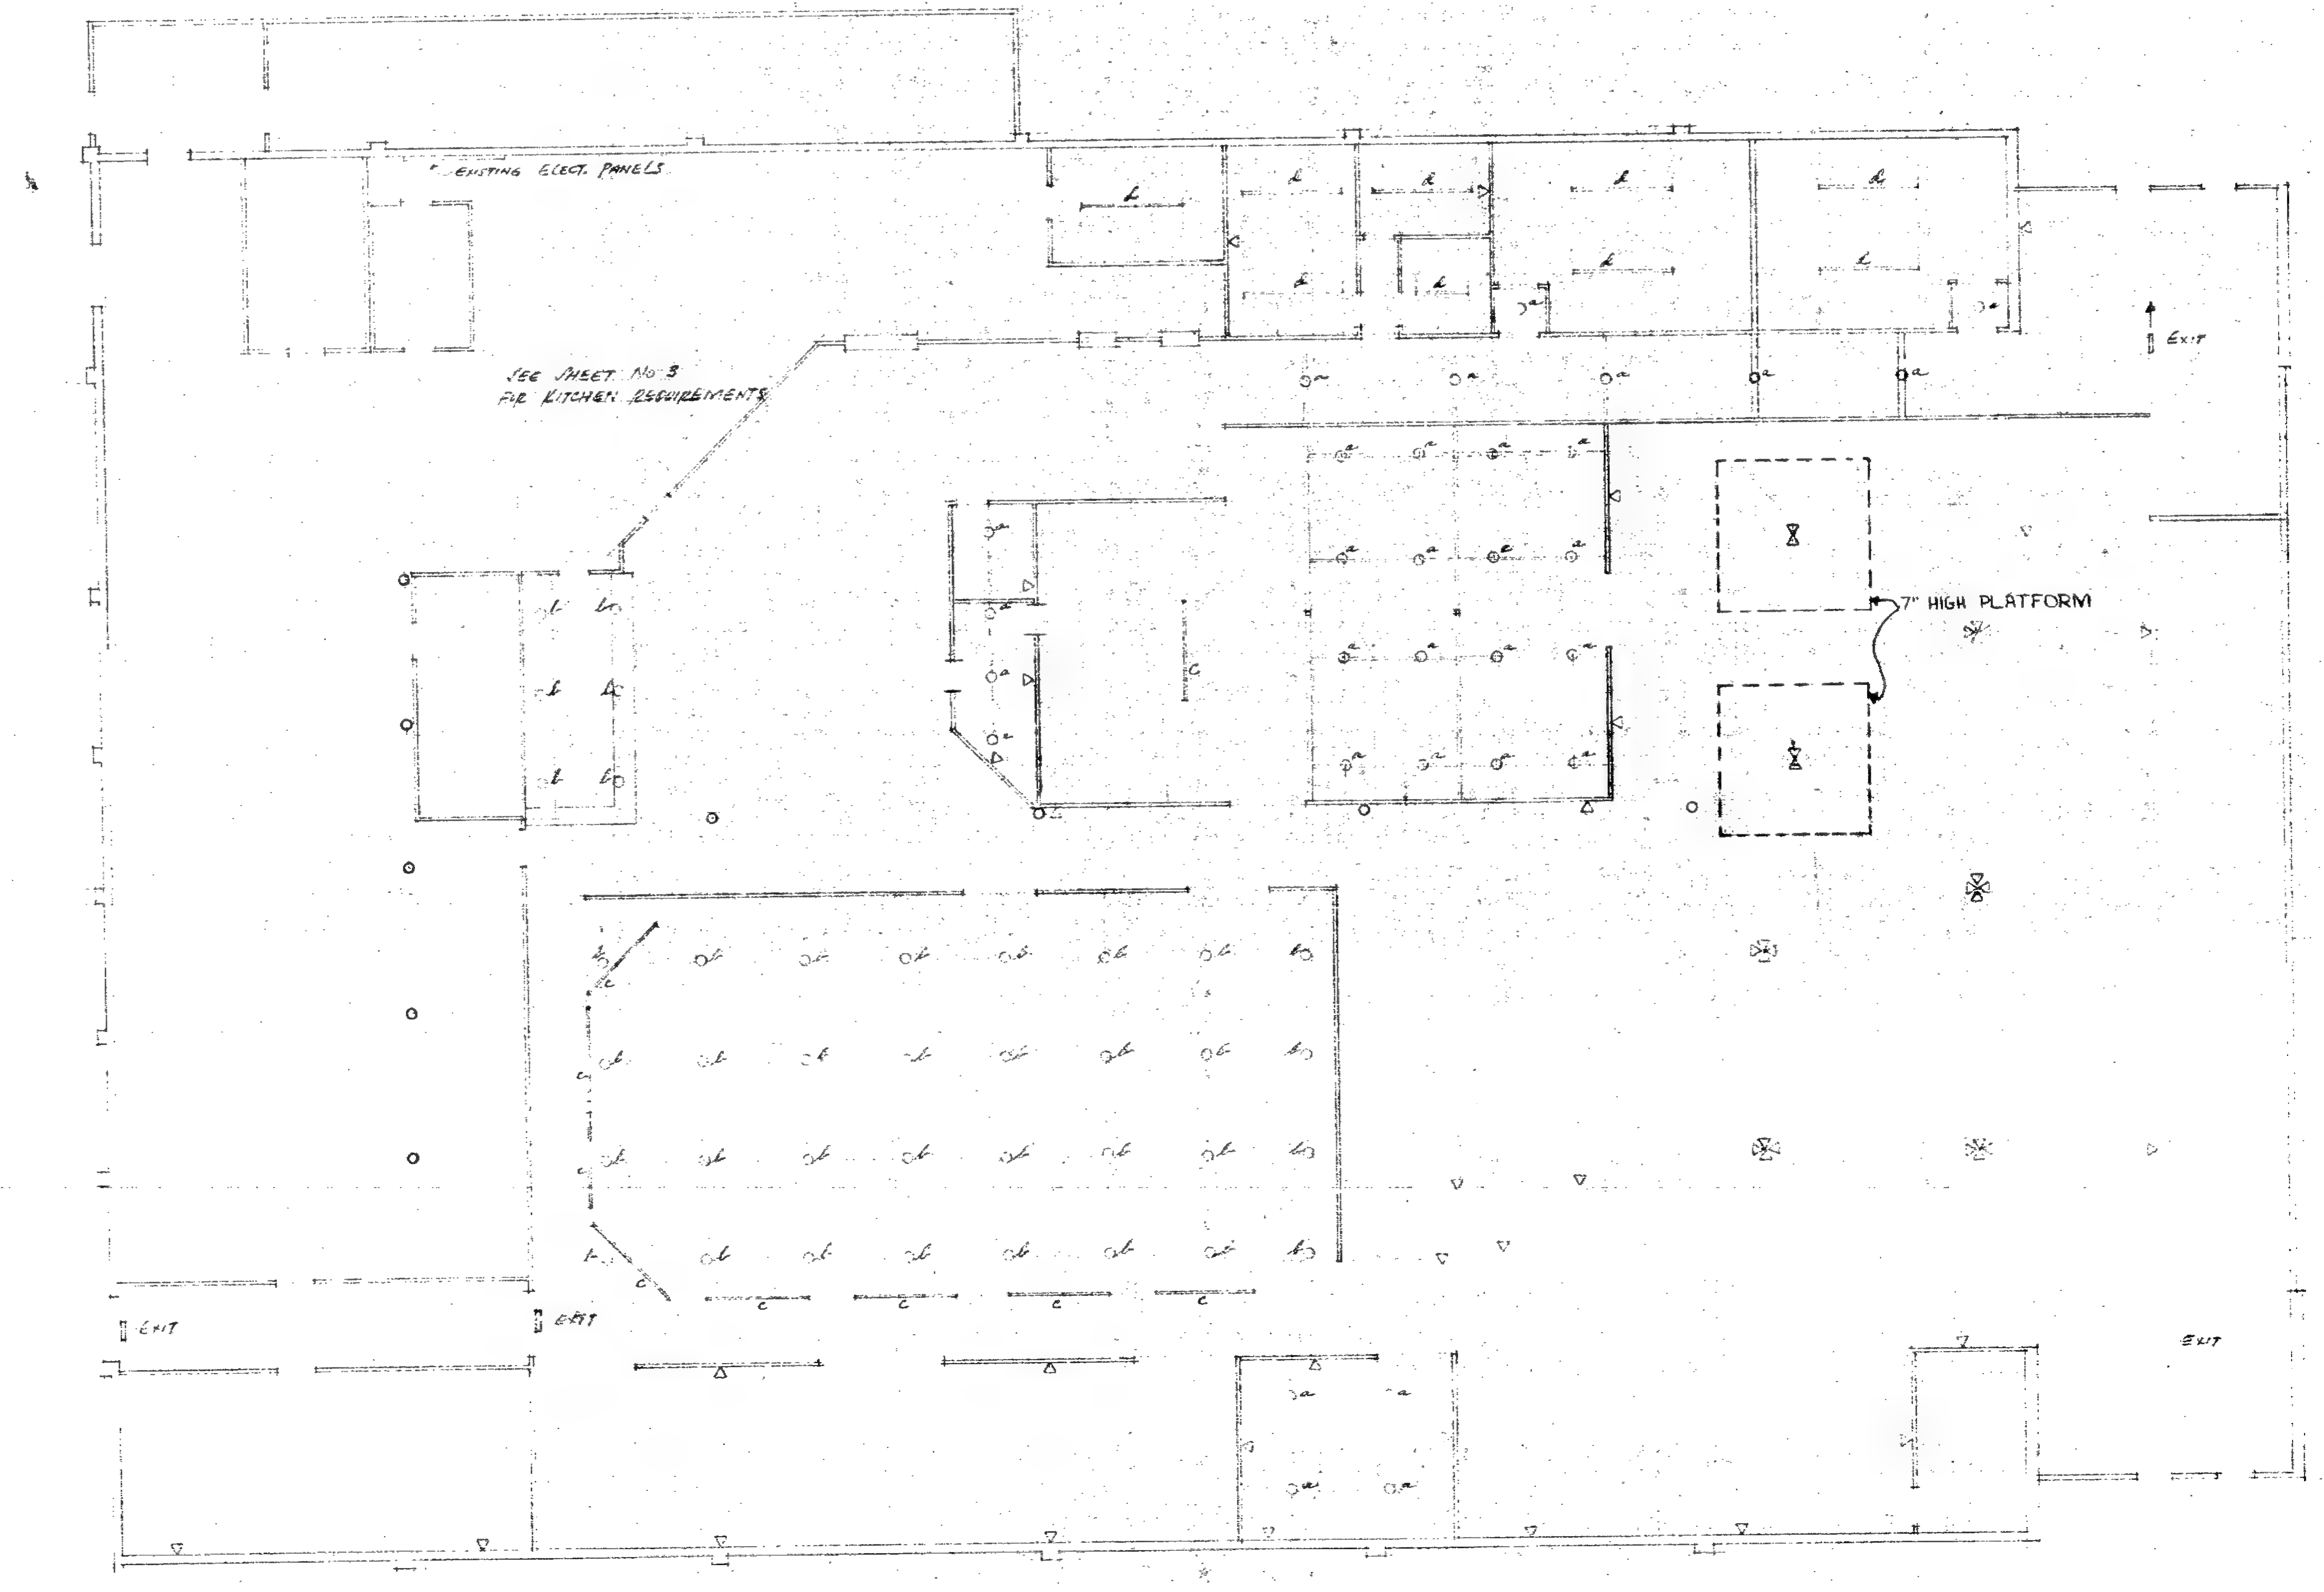

REFLECTED CEILING PLAN
1/8" = 1'-0"

FIXTURE SCHEDULE

a. HALO H-2313 SURFACE MOUNT CYLINDER, 75 WATT R-30 LAMPS
b. SAME AS a EXCEPT TO BE HUNG AT 12'-0' WITH TUBULAR SUPPORT HANGERS.
c. LIGHTOLIER TWO CIRCUIT TRACK LIGHTS HUNG AT 12'-0', 4'-0" LONG RUN TO INDIVIDUAL SWITCHES PROVIDE (24) LIGHTS.
d. SURFACE MOUNT (2) LIGHT FLOURESCANT FIXTURES, SWITCH TO PANEL.

▽ WHERE SHOWN PROVIDE 20 AMP. 115/[illegible] PLUG OUTLET. IN WALLS AT +12". IN FLOOR PROVIDE FLUSH SCREW COVER.

PROVIDE EXIT & EMERGENCY LIGHTS AS REQUIRED BY FIRE MARSHALL

EXITING LIGHTING TO REMAIN FOR ALL AREAS. RELAMP AS DIRECTED BY OWNER.

SUPERSEDED
10/27/78 WAT
ORIGINAL
SEE REVISED 2

11

12341

PIZZA TIME THEATRE
SAN JOSE, CA.

BY
DESIGN SERVICES
MENLO PARK, CA.

SHEET NO 4

	SQ FT.	SEATS	PARKING
THEATRE DINNING	2048	152	60.8
ADULT DINNING	1254	67	26.8
PRIVATE DINNING	840	40	16.0
TOTAL	4142	259	103.6

WOMENS
PROVIDE (5) WATER CLOSETS, (3) LAVATORIES, MIRRORS, SOAP DISPENSERS, TOWEL DISPENSERS. ONE TOILET ENCLOSURE TO HAVE 2'-8" DOOR & GRAB BARS.
MEN'S
PROVIDE (2) WATER CLOSETS, (3) URINALS, (3) LAVATORIES, MIRRORS SOAP DISP., TOWEL DISPENSERS. ONE TOILET ENCLOSURE TO HAVE 2'-8" DOOR & GRAB BARS.

HANDICAPED REQUIREMENTS TO BE U.B.C. 1711.

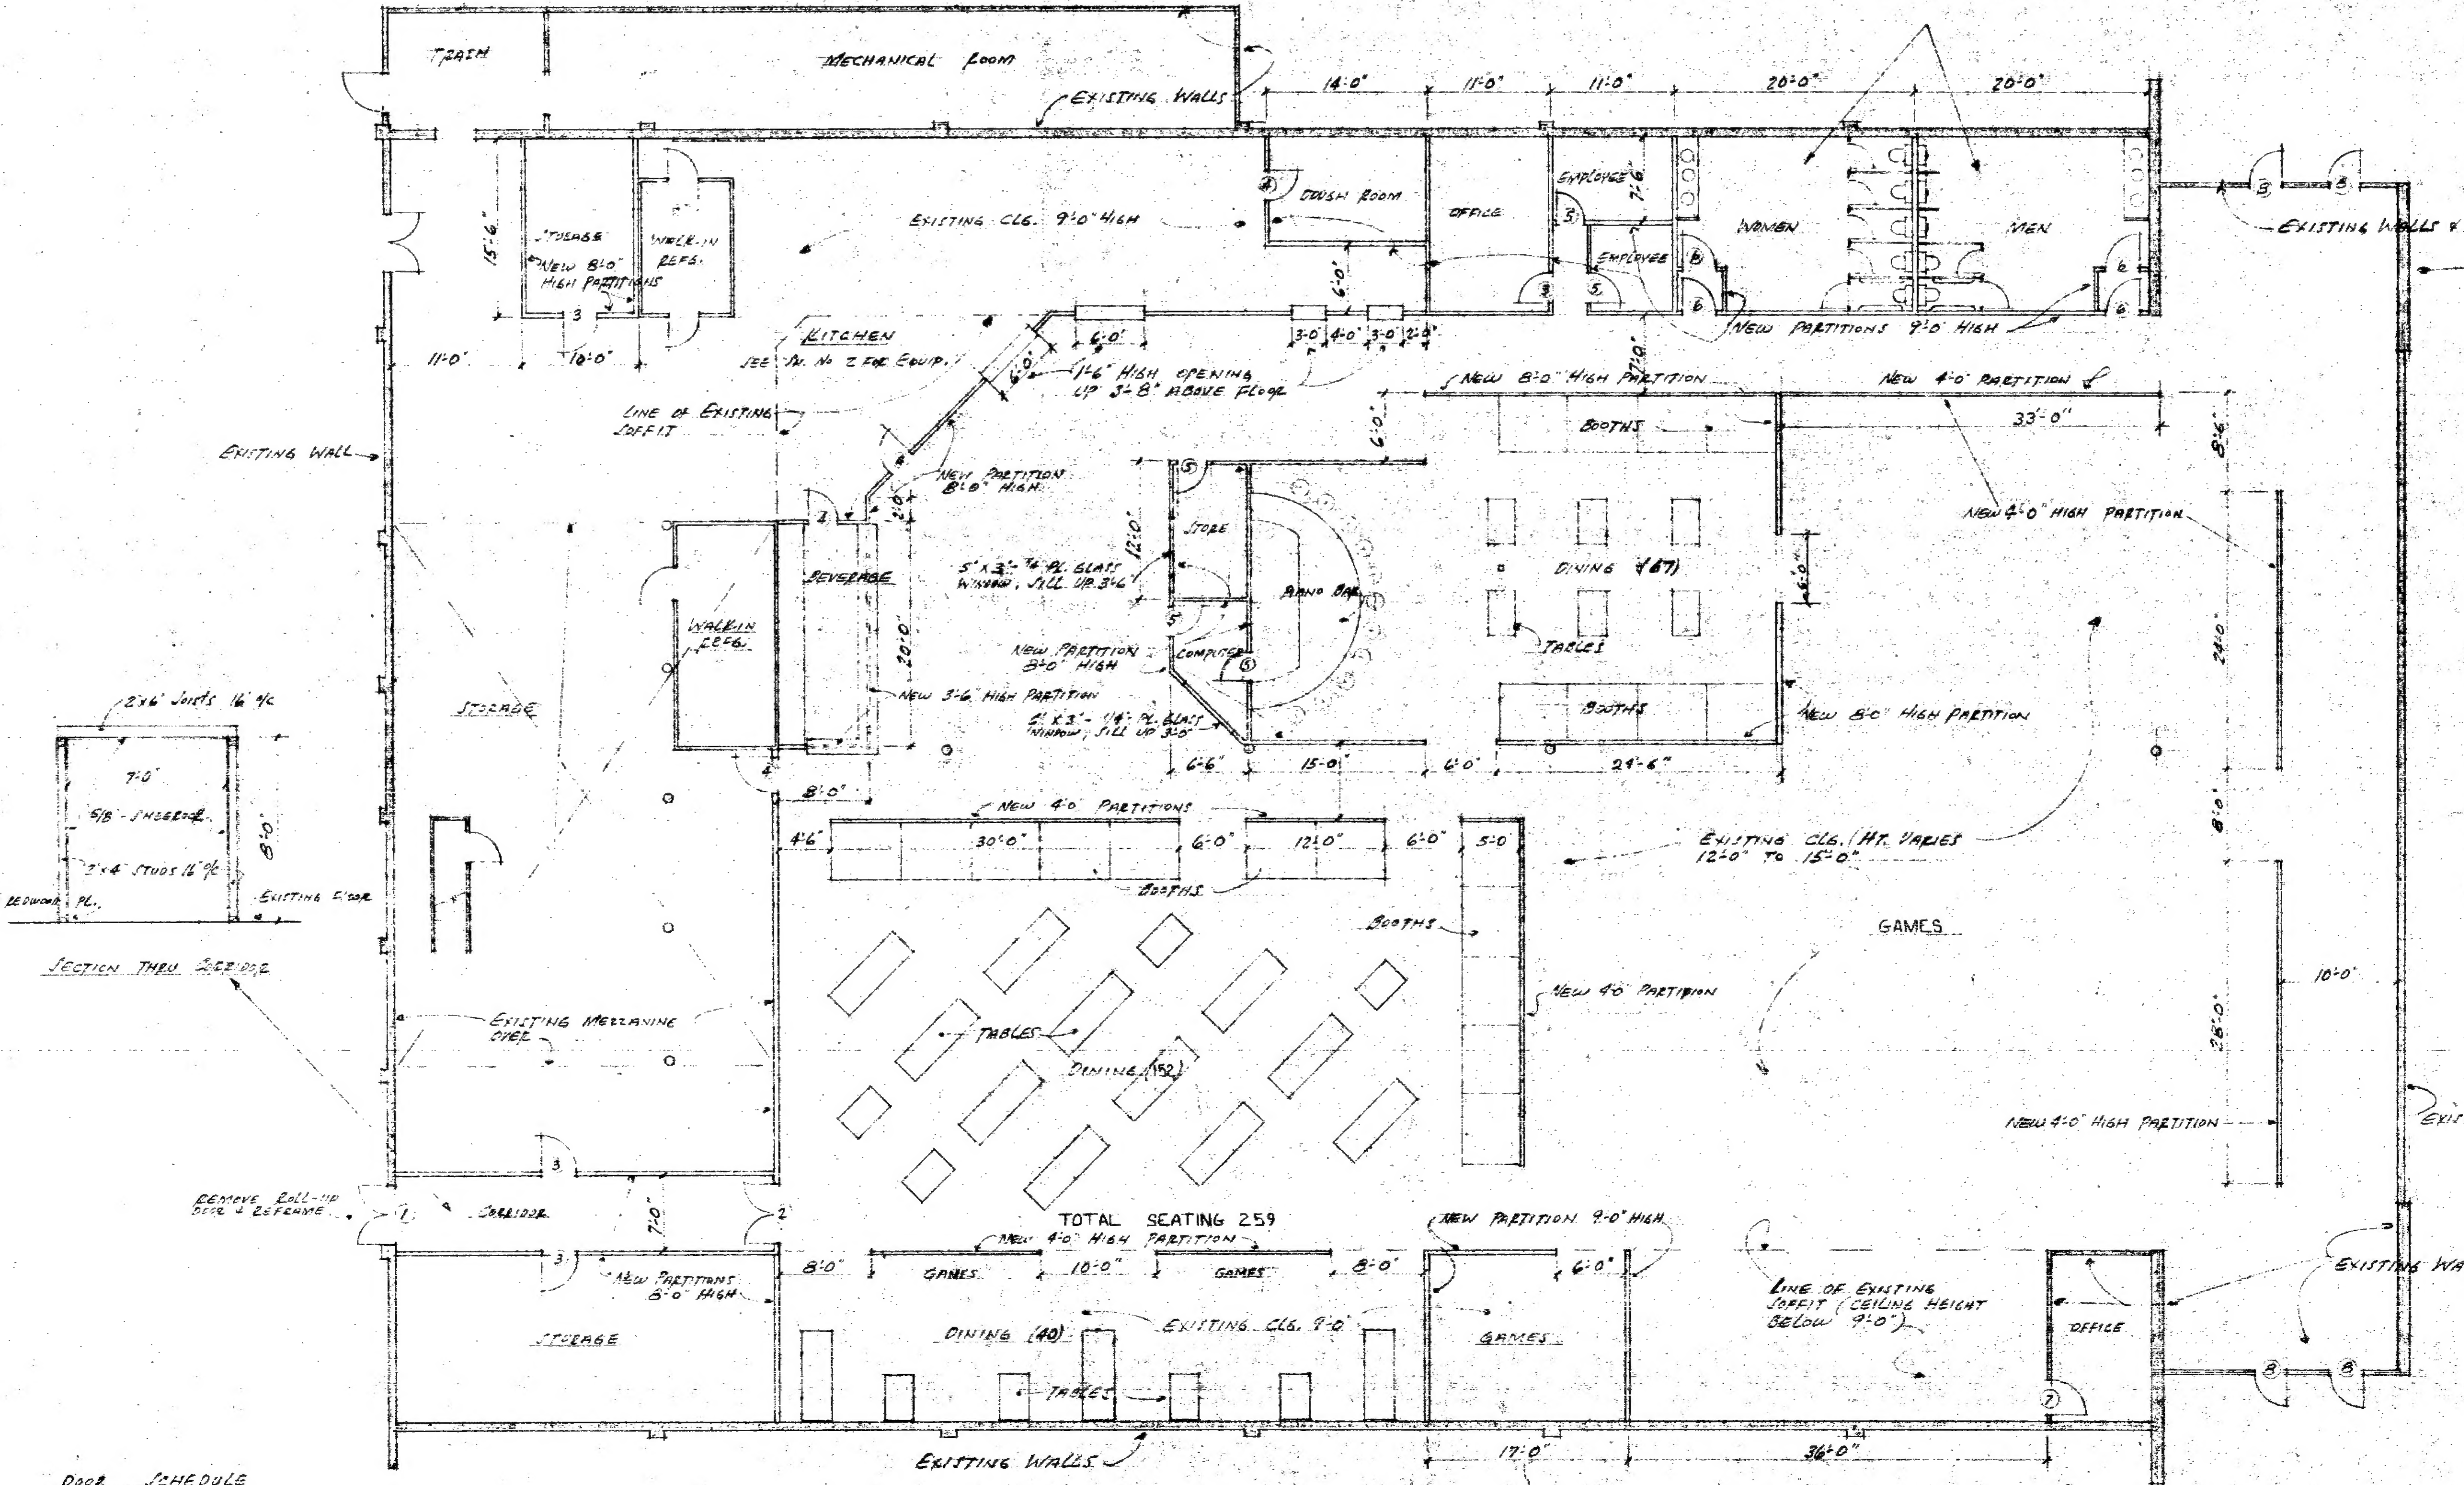

NOTES
1. ALL NEW PARTITIONS TO BE 2"x4" @ 16" o/c WITH 5/8" SHEET ROCK BOTH SIDES.
2. FINISH OF KITCHEN, DOUGH ROOM, STORAGE, MENS & WOMENS TOILETS TO BE TWO (2) COATS SEMI-GLOSS ENAMEL; LIGHT COLOR.
3. NO STRUCTURAL CHANGES ARE TO BE MADE.
4. IN KITCHEN PROVIDE (2) 20-B-C FIRE EXTINGUISHERS. IN DINING PROVIDE (2) 2-A-10B-C FIRE EXTINGUISHERS.
5. ALL WOOD PANELING OR DECORATIVE MATERIALS SHALL BE FLAME TREATED.
6. ALL NEW PARTITIONS TO HAVE 2"x4" REDWOOD SILL PLATE ANCHORED TO CONCRETE SLAB ON 4'-0" CENTERS WITH HILTI OR EQUAL FASTENERS.

Date 8-23-78 No.
APPROVED as submitted
as corrected X
ENVIRONMENTAL MANAGEMENT AGENCY
ENVIRONMENTAL HEALTH SERVICES
By Edward W. Smith, R.S.

Note:
The exhaust fans for hoods must be sufficient to draw 4200 cfm's
EWS

12

DOOR SCHEDULE

No.	SIZE	TYPE	MISC.
1.	3°-6⁸	SOLID CORE	PANIC HARDWARE - CLOSER
2.	3°-6⁸	HOL. CORE	" " "
3.	3°-6⁸	SOLID CORE	DEAD BOLT LOCK
4.	3°-6⁸	HOL. CORE	NO LOCKS - CLOSER
5.	3°-6⁸	HOL. CORE	DEAD BOLT LOCK
6.	2⁰-6⁸	HOL. CORE	CLOSER
7.	EXISTING		ADD DEAD BOLT LOCK
8.	"		ADD PANIC HARDWARE

ALL DOOR UNLISTED ARE EXISTING WITH NO CHANGES

FLOOR PLAN
1/8" = 1'-0"

PAID
$20.00 cfm
8-1-78
R# 111759

PIZZA TIME THEATRE, INC
SAN JOSE, CA.
SITE: 1371 KOOSER Rd.
San Jose CA
BY
DESIGN SERVICES
MENLO PARK, CA.
PTT ENG.: Grey Tilden
968-3861
968-3866
SCALE: 1/8" = 1'0"
SHEET NO.

12341

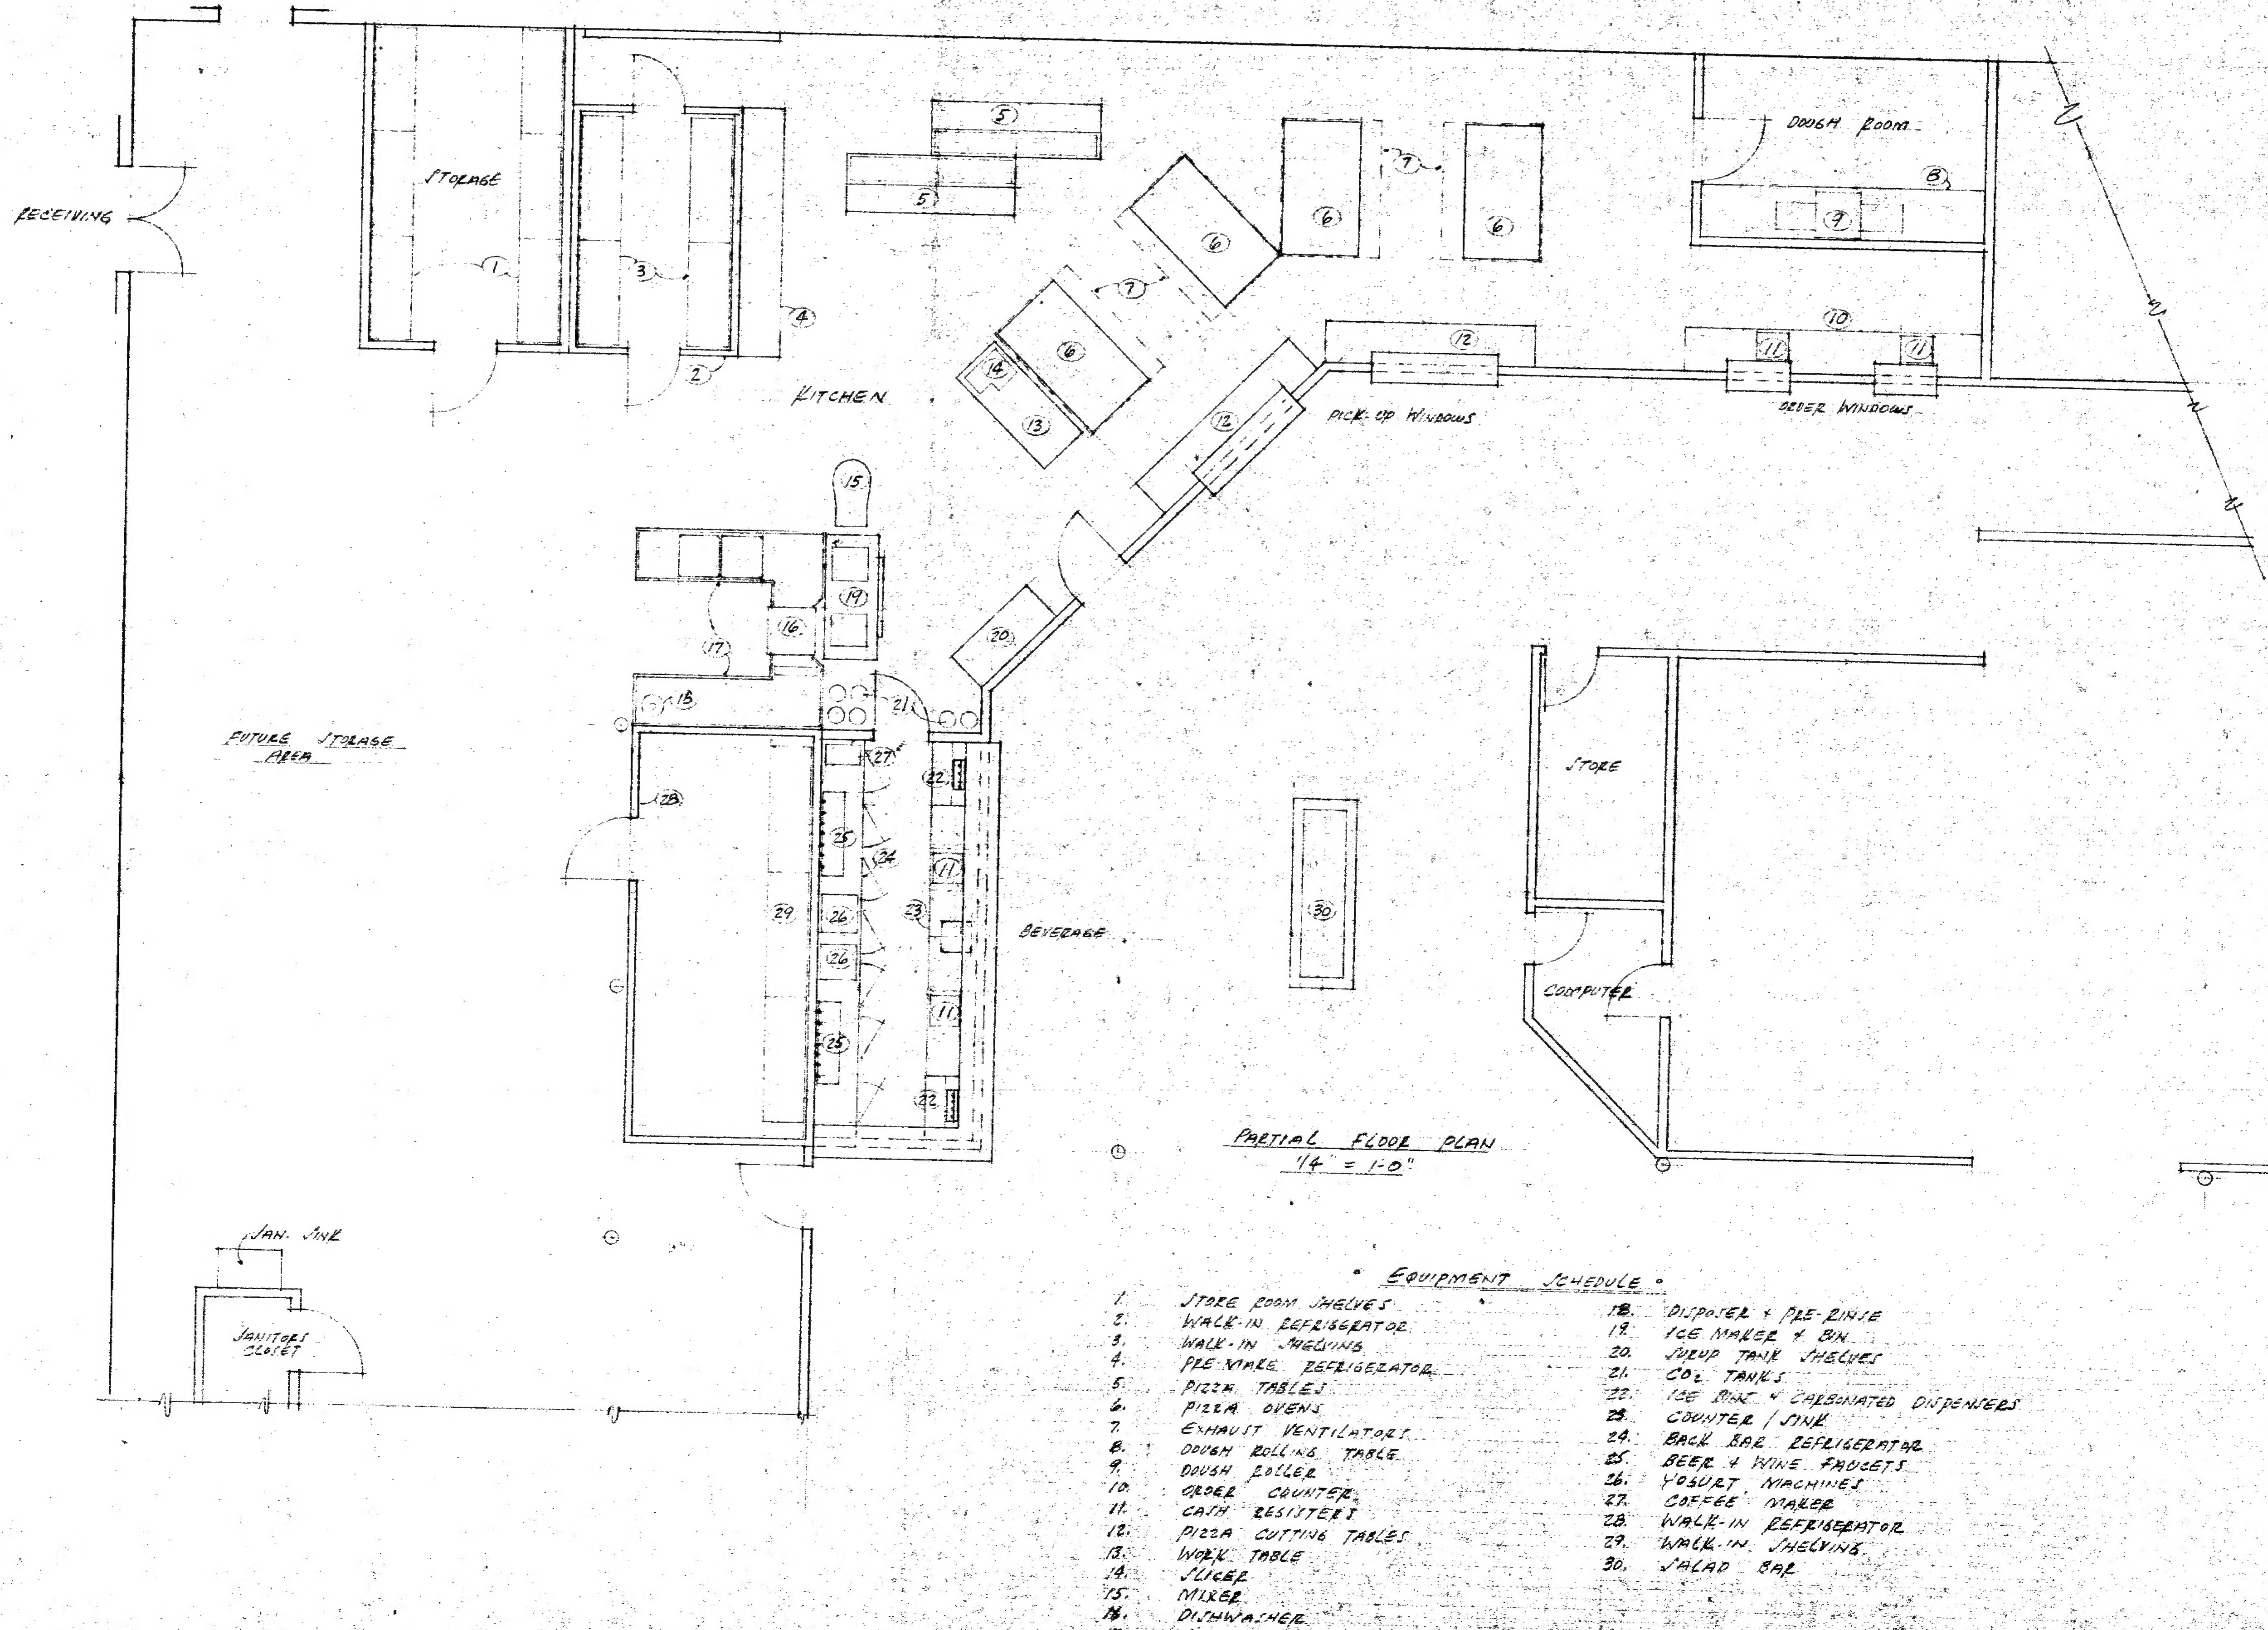

PARTIAL FLOOR PLAN
1/4" = 1-0"

• EQUIPMENT SCHEDULE •

1. STORE ROOM SHELVES
2. WALK-IN REFRIGERATOR
3. WALK-IN SHELVING
4. PRE-MAKE REFRIGERATOR
5. PIZZA TABLES
6. PIZZA OVENS
7. EXHAUST VENTILATORS
8. DOUGH ROLLING TABLE
9. DOUGH ROLLER
10. ORDER COUNTER
11. CASH RESISTERS
12. PIZZA CUTTING TABLES
13. WORK TABLE
14. SLICER
15. MIXER
16. DISHWASHER
17. SOILED + CLEAN TABLES
18. DISPOSER + PRE-RINSE
19. ICE MAKER + BIN
20. SYRUP TANK SHELVES
21. CO_2 TANKS
22. ICE BINS + CARBONATED DISPENSERS
23. COUNTER / SINK
24. BACK BAR REFRIGERATOR
25. BEER + WINE FAUCETS
26. YOGURT MACHINES
27. COFFEE MAKER
28. WALK-IN REFRIGERATOR
29. WALK-IN SHELVING
30. SALAD BAR

13

12341

PIZZA TIME THEATRE
SAN JOSE, CA.
BY
DESIGN SERVICES
MENLO PARK, CA.

SHEET No 2

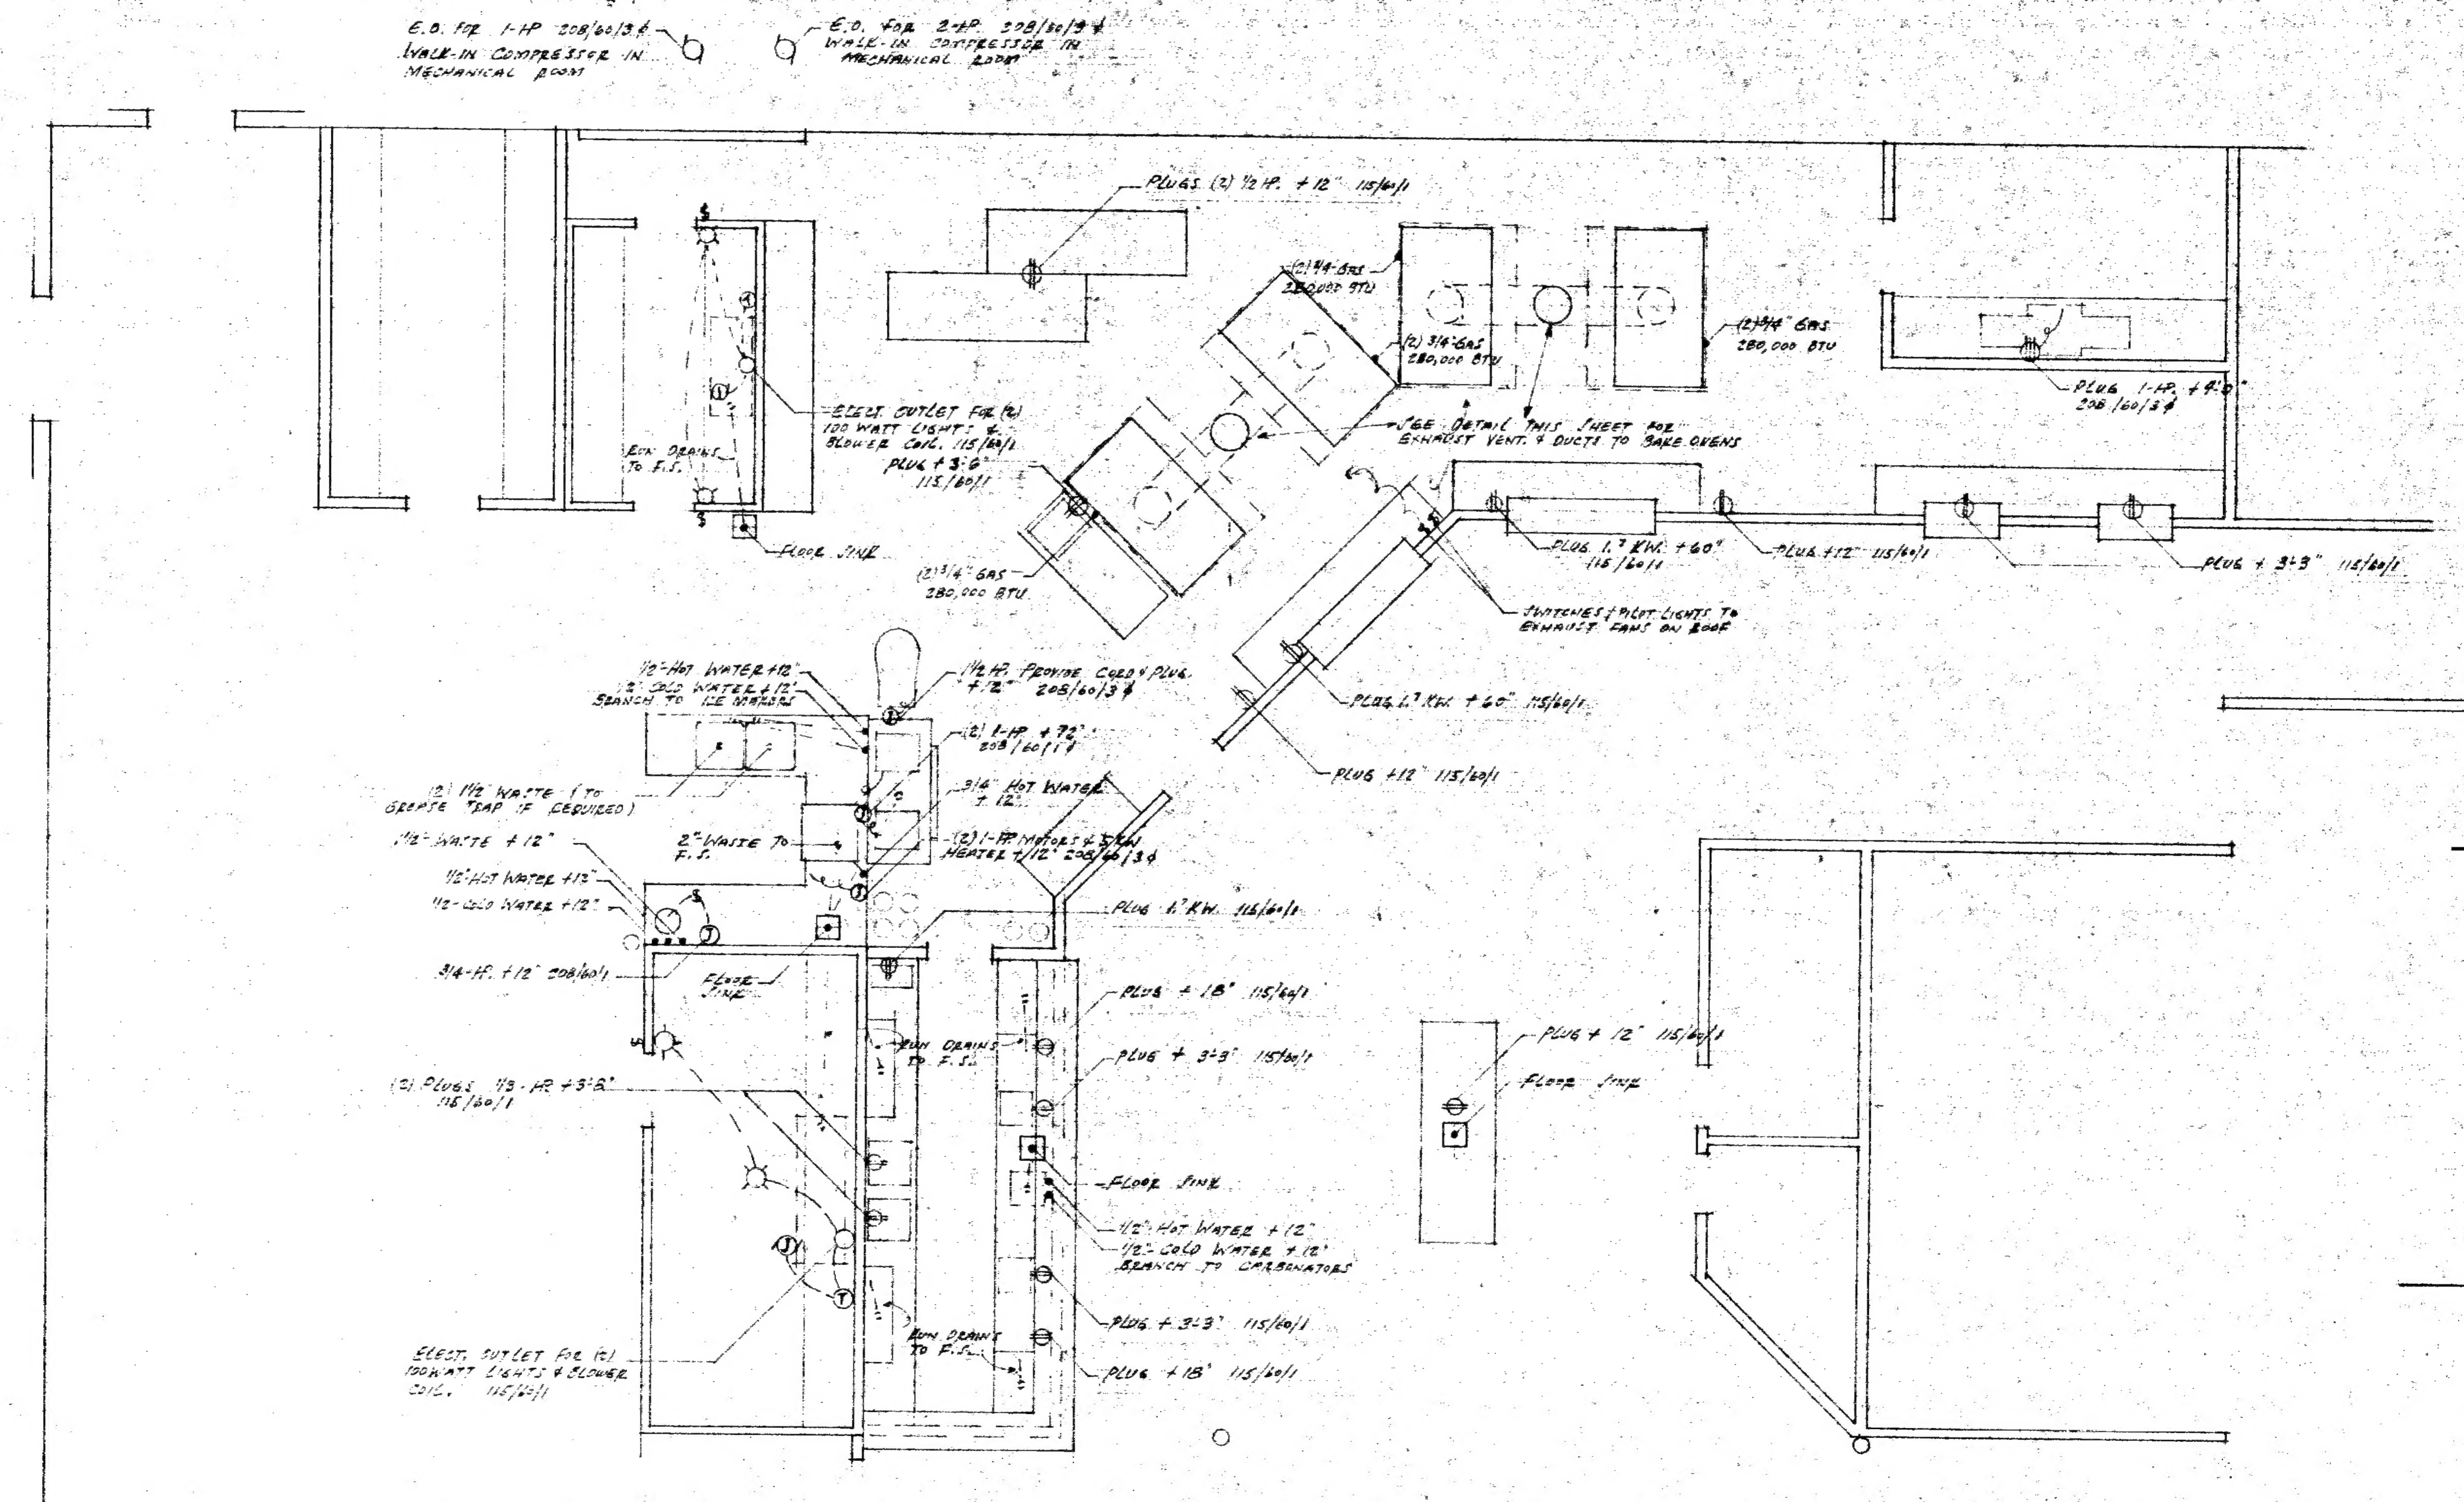
E.O. FOR 1-HP 208/60/3∅ WALK-IN COMPRESSOR IN MECHANICAL ROOM
E.O. FOR 2-HP 208/60/3∅ WALK-IN COMPRESSOR IN MECHANICAL ROOM
PLUGS (2) ½ HP. + 12" 115/60/1
(2) ¾" GAS 280,000 BTU
(2) ¾" GAS 280,000 BTU
(2) ¾" GAS 280,000 BTU
(2) ¾" GAS 280,000 BTU
PLUG 1-HP. + 4'-0" 208/60/3∅
ELECT. OUTLET FOR (2) 100 WATT LIGHTS & BLOWER COIL. 115/60/1
PLUG + 3'-6" 115/60/1
RUN DRAINS TO F.S.
FLOOR SINK
SEE DETAIL THIS SHEET FOR EXHAUST VENT. & DUCTS TO BAKE OVENS
PLUG 1.7 KW. + 60" 115/60/1
PLUG + 12" 115/60/1
PLUG + 3'-3" 115/60/1
SWITCHES & PILOT LIGHTS TO EXHAUST FANS ON ROOF
PLUG 1.7 KW. + 60" 115/60/1
PLUG + 12" 115/60/1
½" HOT WATER + 12"
½" COLD WATER + 12" BRANCH TO ICE MAKERS
1½ HP. PROVIDE CORD & PLUG + 12" 208/60/3∅
(2) 1-HP + 72" 208/60/1∅
(2) 1½" WASTE (TO GREASE TRAP IF REQUIRED)
¾" HOT WATER + 12"
2" WASTE TO F.S.
½" WASTE + 12"
(2) 1-HP MOTORS & 5 KW HEATER + 12" 208/60/3∅
½" HOT WATER + 12"
½" COLD WATER + 12"
PLUG 1' KW. 115/60/1
¾-HP. + 12" 208/60/1
FLOOR SINK
PLUG + 18" 115/60/1
RUN DRAINS TO F.S.
PLUG + 3'-3" 115/60/1
(2) PLUGS ⅓-HP + 3'-8" 115/60/1
FLOOR SINK
½" HOT WATER + 12"
½" COLD WATER + 12" BRANCH TO CARBONATORS
PLUG + 3'-3" 115/60/1
RUN DRAINS TO F.S.
ELECT. OUTLET FOR (2) 100 WATT LIGHTS & BLOWER COIL. 115/60/1
PLUG + 18" 115/60/1
PLUG + 12" 115/60/1
FLOOR SINK

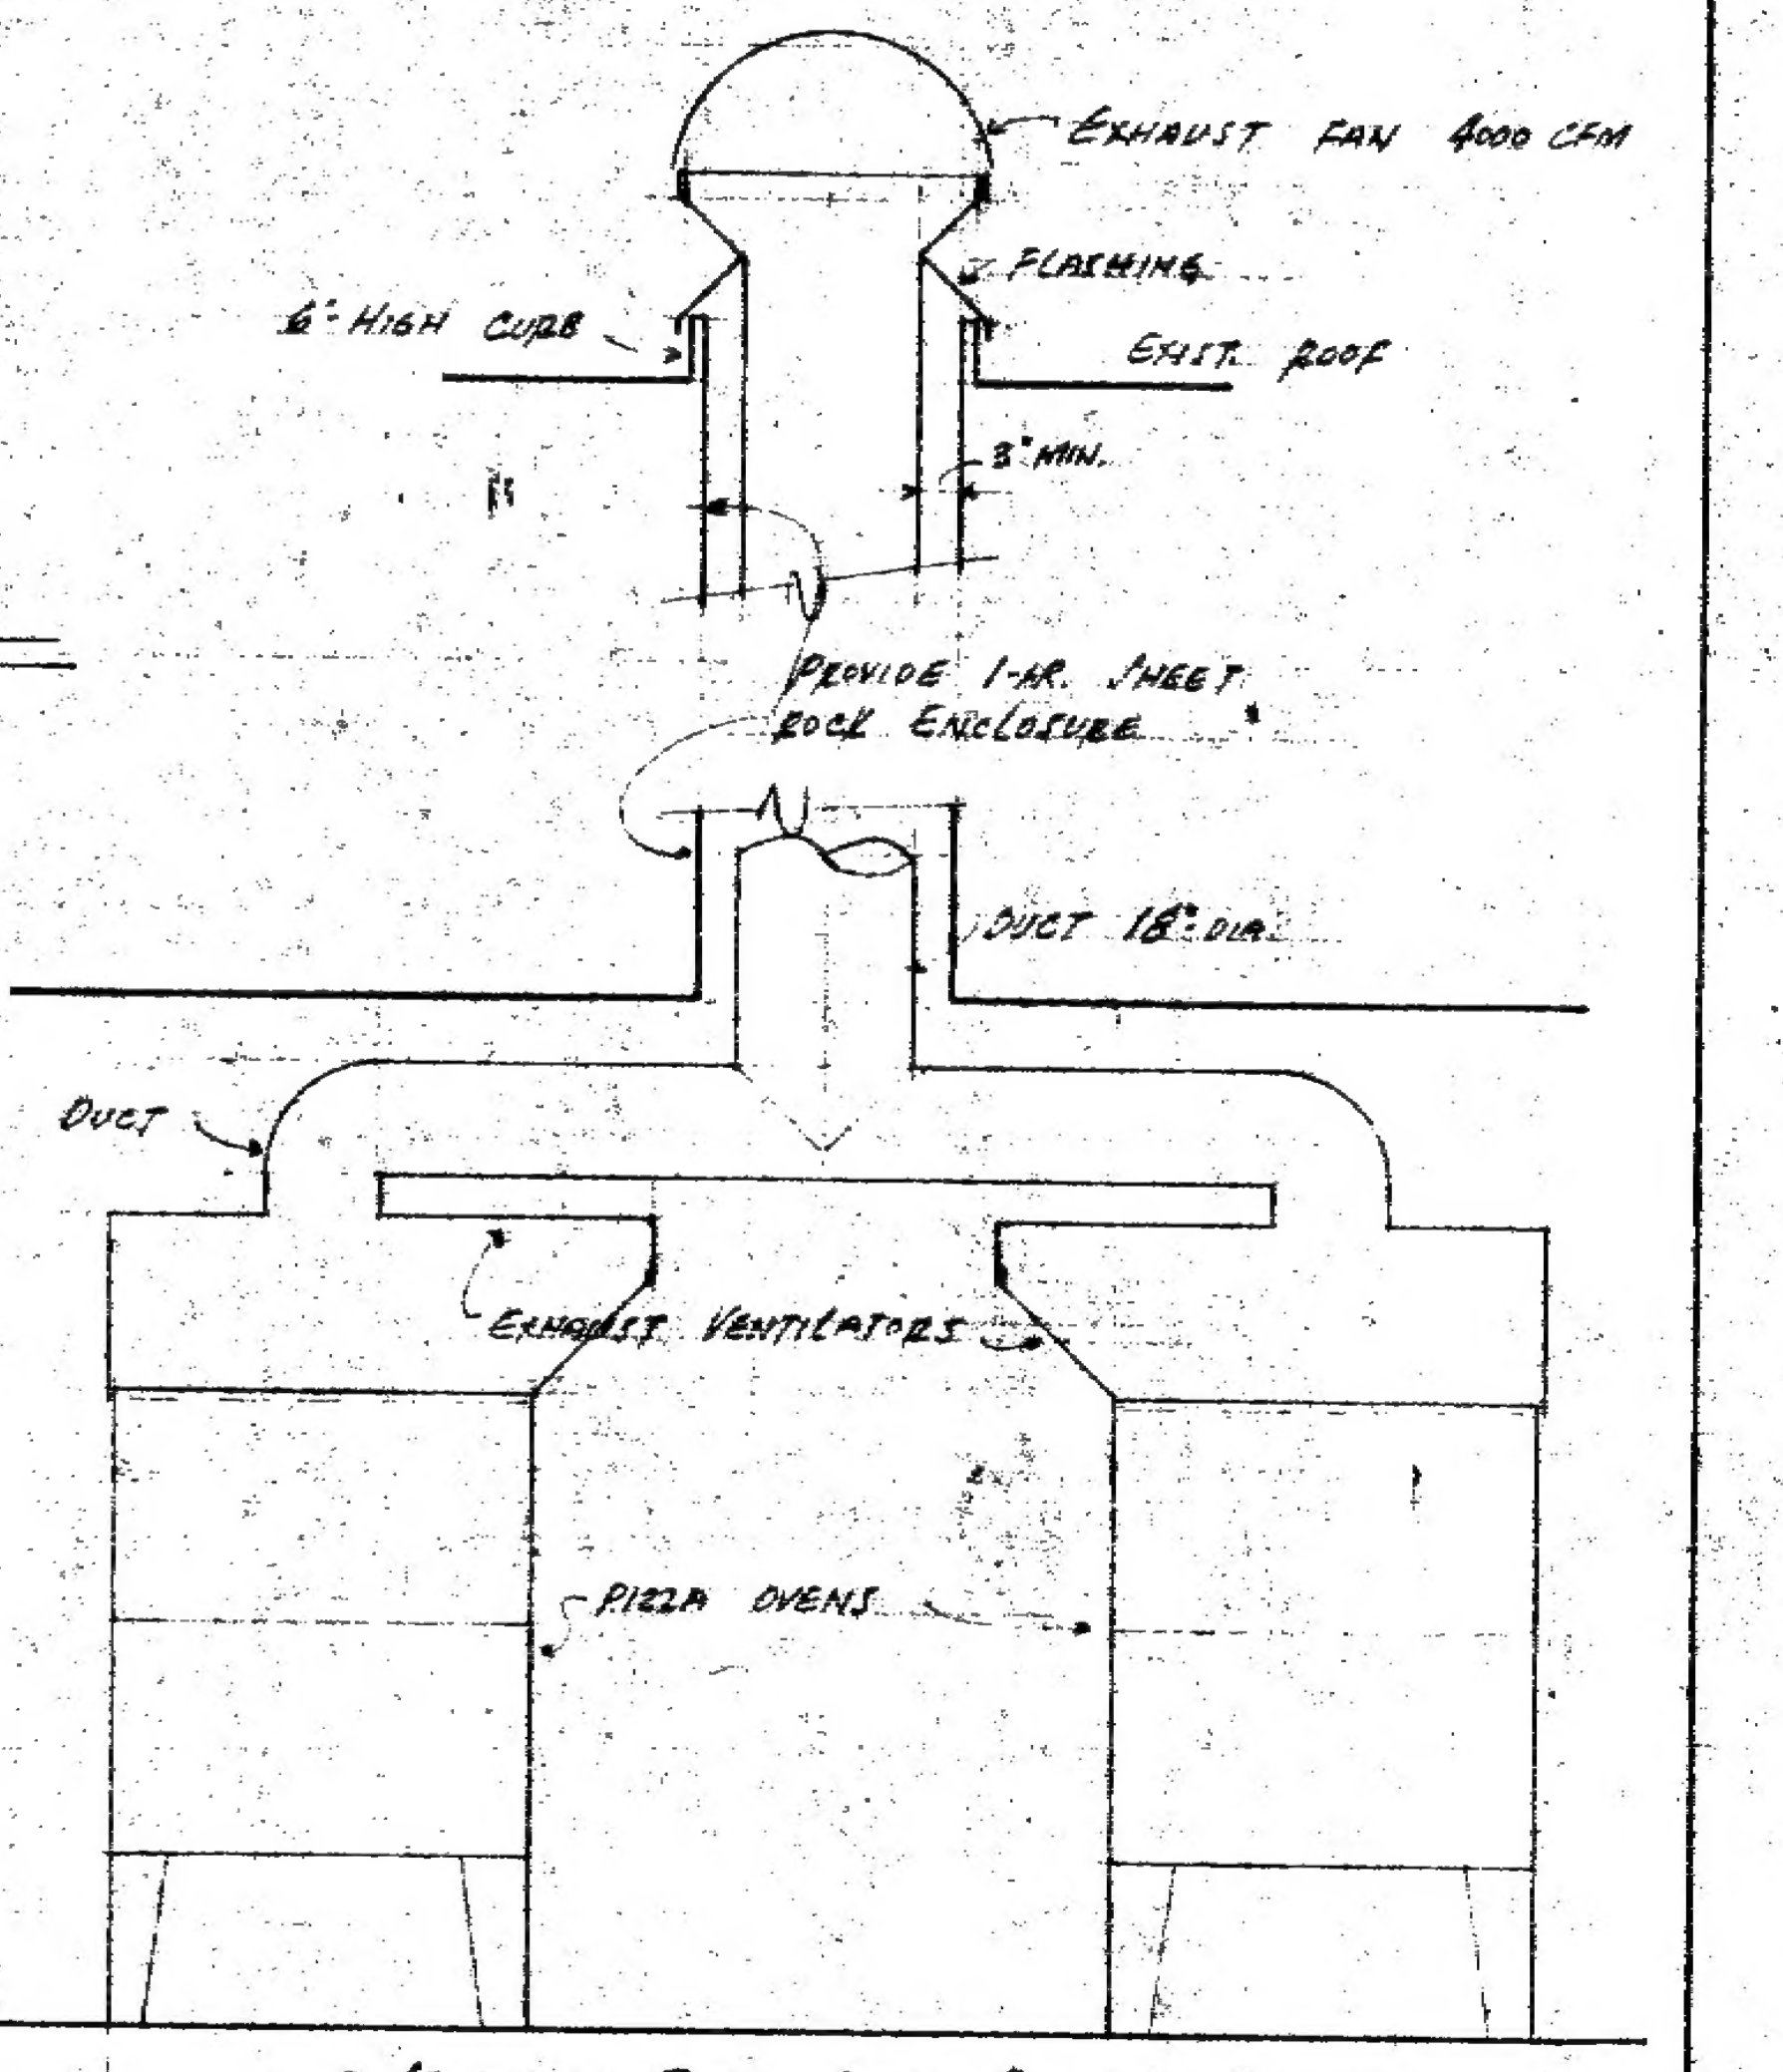

• SECTION THRU OVEN EXHAUST SYSTEMS •

MECHANICAL, ELECTRICAL & PLUMBING FOR
FOOD SERVICE EQUIPMENT

14

12341

PIZZA TIME THEATRE
SAN JOSE, CA.
BY
DESIGN SERVICES
MENLO PARK, CA.

SHEET No. 3

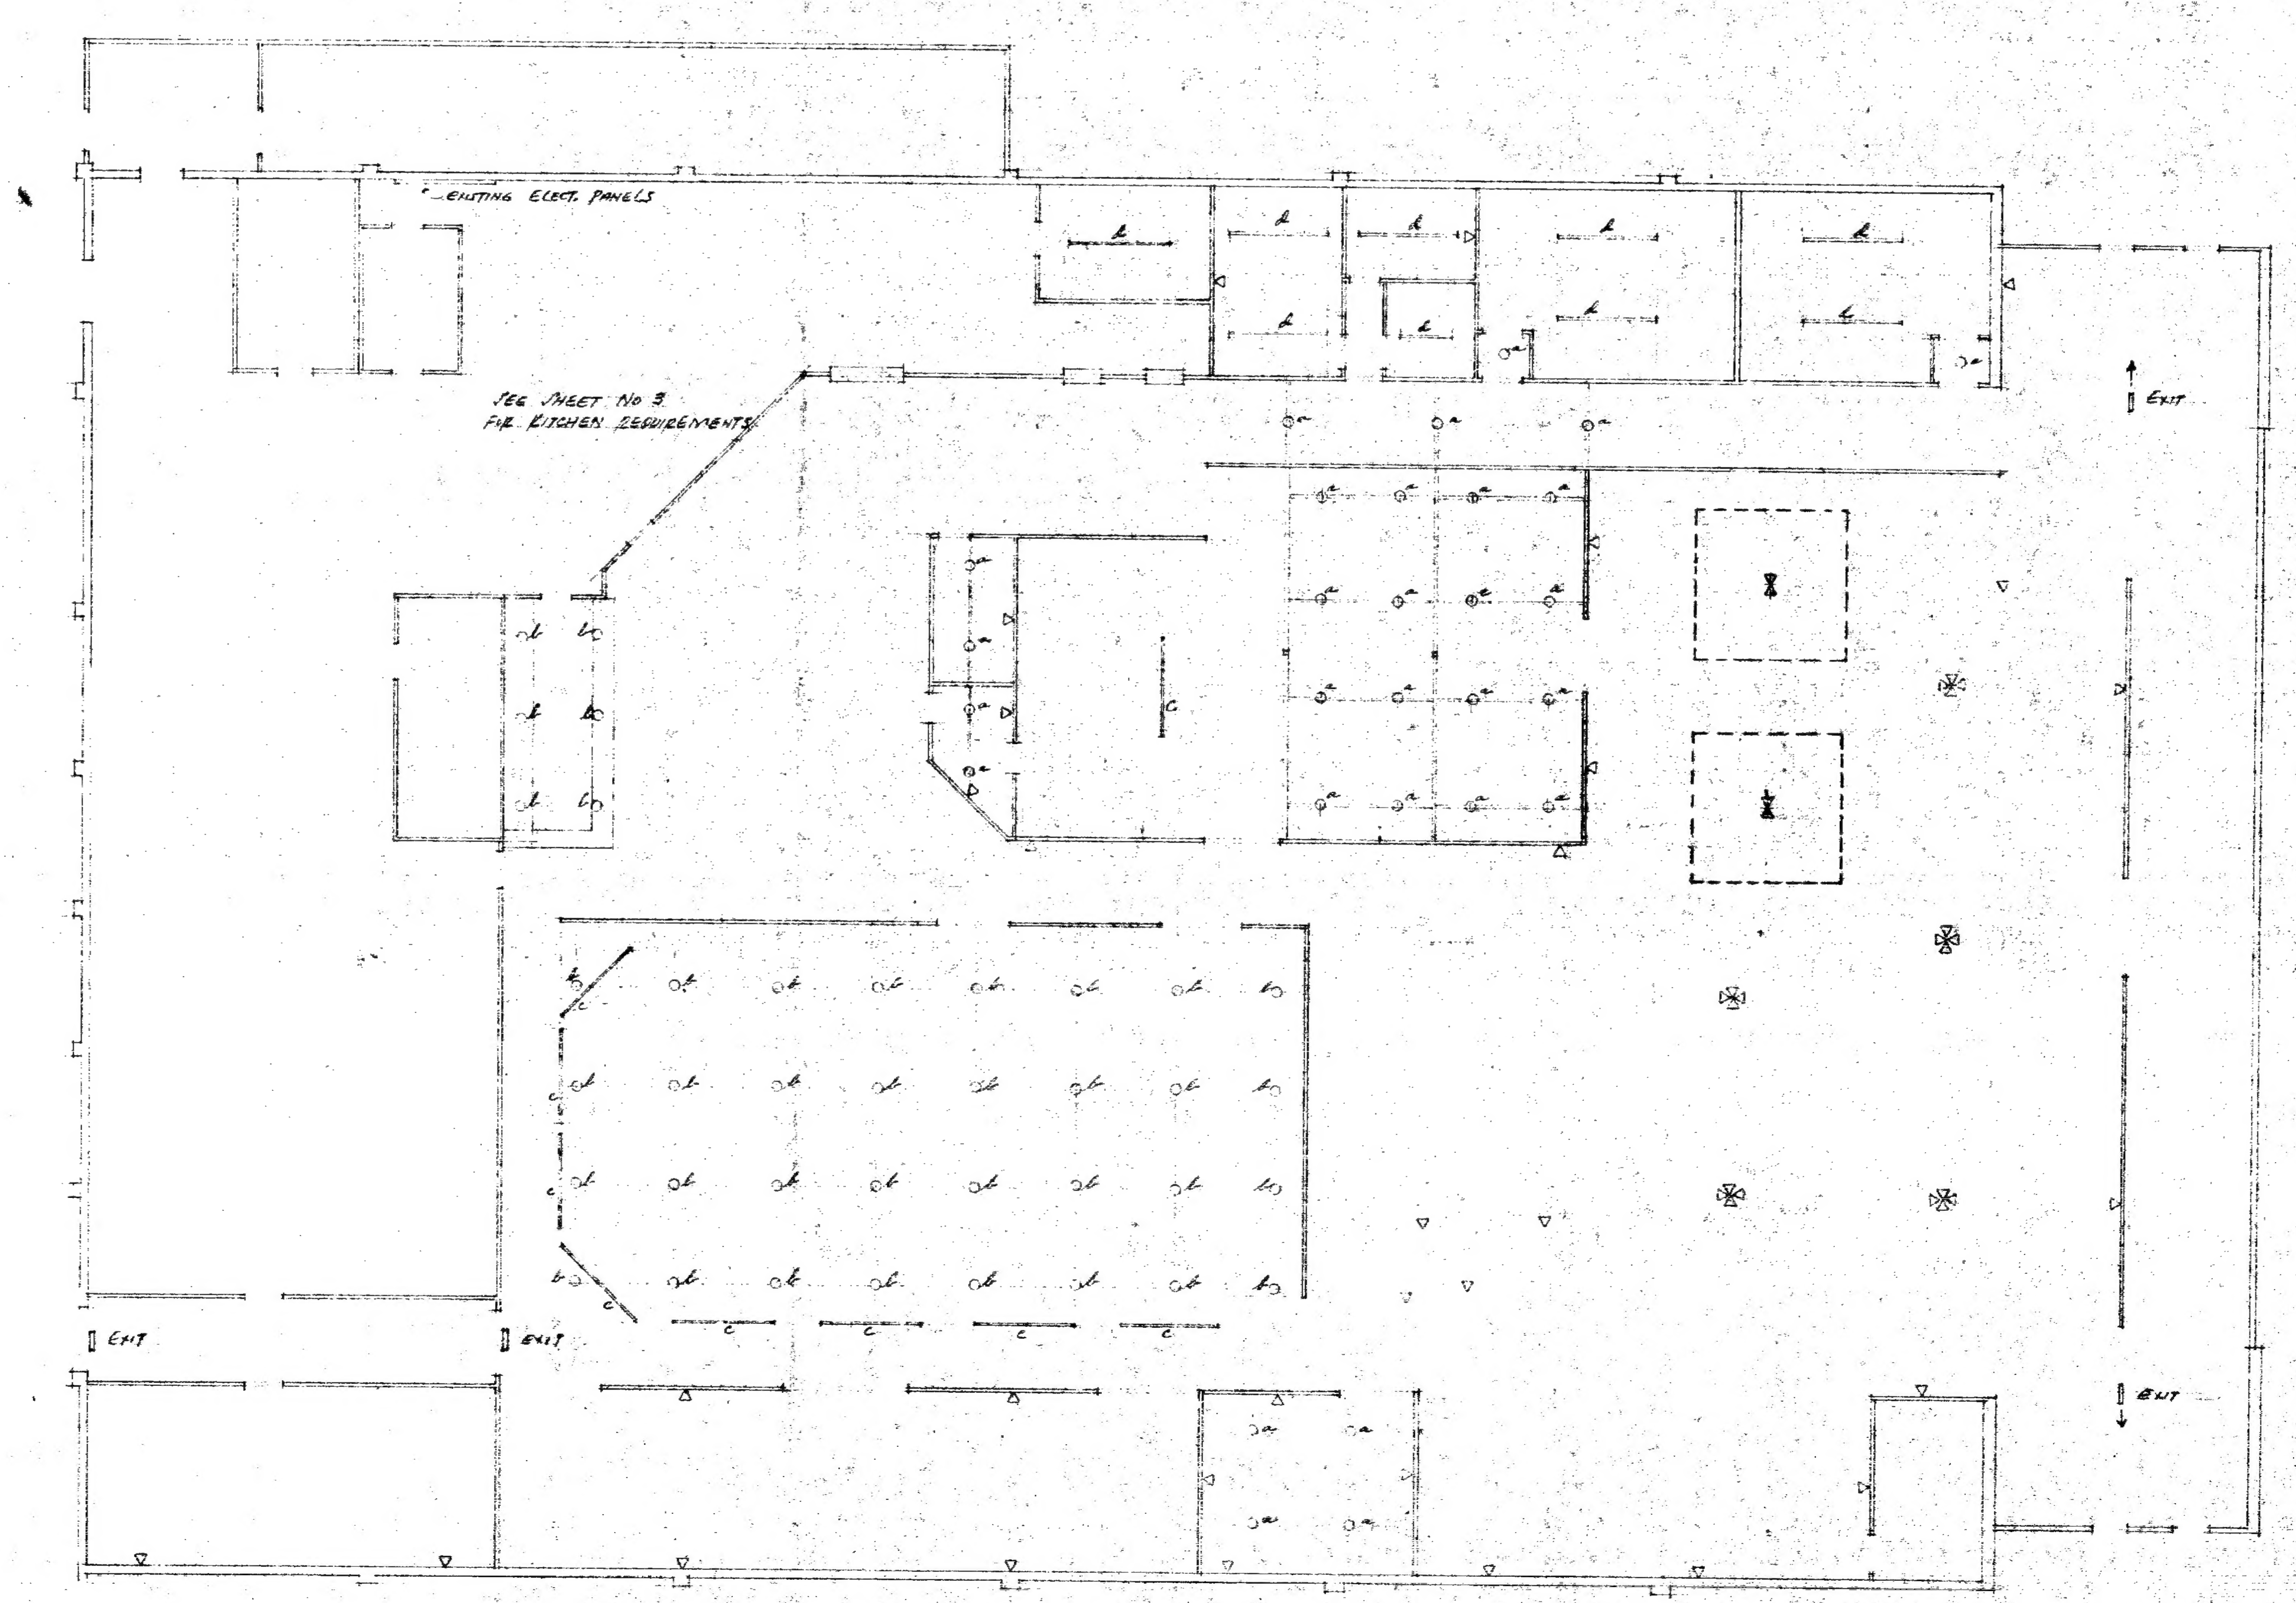

REFLECTED CEILING PLAN
1/8" = 1'-0"

FIXTURE SCHEDULE

a. HALO H-2313 SURFACE MOUNT CLYINDER, 75 WATT R-30 LAMPS.
b. SAME AS a EXCEPT TO BE HUNG AT 12'-0" WITH TUBULAR SUPPORT HANGERS.
c. LIGHTOLIER TWO CIRCUIT TRACK LIGHTS HUNG AT 12'-0", 4'-0" LONG RUN TO INDIVIDUAL SWITCHES PROVIDE (24) LIGHTS.
d. SURFACE MOUNT (2) LIGHT FLOURESCANT FIXTURES, SWITCH TO PANEL.

▽ WHERE SHOWN PROVIDE 30 AMP 115/60/1 ϕ PLUG OUTLET. IN WALLS AT +12". IN FLOOR PROVIDE FLUSH SCREW COVER.

PROVIDE EXIT & EMERGENCY LIGHTS AS REQUIRED BY FIRE MARSHALL

EXITING LIGHTING TO REMAIN FOR ALL AREAS. RELAMP AS DIRECTED BY OWNER.

15

12341

PIZZA TIME THEATRE
SAN JOSE, CA.

BY
DESIGN SERVICES
MENLO PARK, CA.

SHEET No